
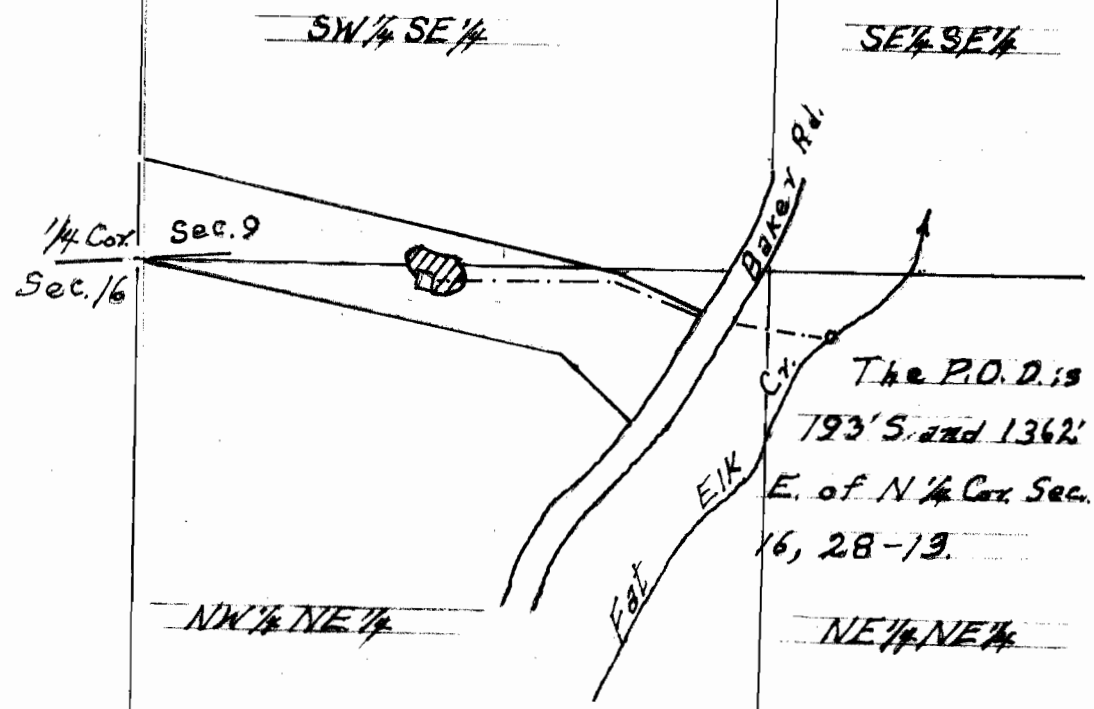


DEC 17 1990
JAN 29 1991

T. 28 S., R. 13 W. W.M.
SECTION 16

Scale: 1" = 400ft.

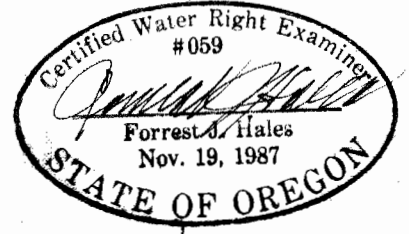

FINAL PROOF SURVEY
UNDER

Application No. 70062 Permit No. 50931

IN NAME OF
LEWIS R. WILSON

Surveyed October 21, 1990. + 1-28-91
F.L.H.