


T.3S.,R.1W.,W.M.

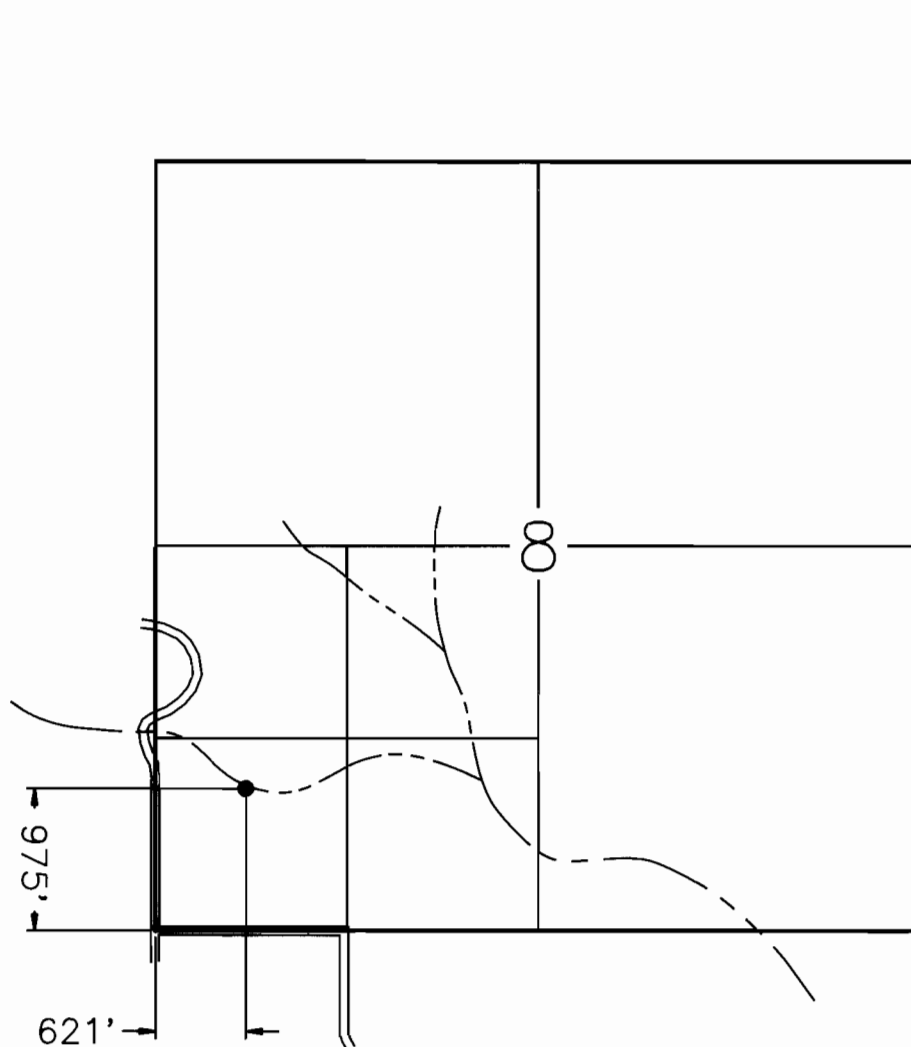

FINAL PROOF SURVEY
UNDER

Application No. R-70732 Permit No. R-11261
A.G. (Sam) Sumner

Sherwood, Oregon

Surveyed December 18, 1990

Alfred Smith
1/16/91

NOTE: This map is for the purpose of identifying the location of the water right only and is not intended to provide legal dimensions or locations of property lines.