


T26S, R6W, WM

SCALE 1" = 1320'

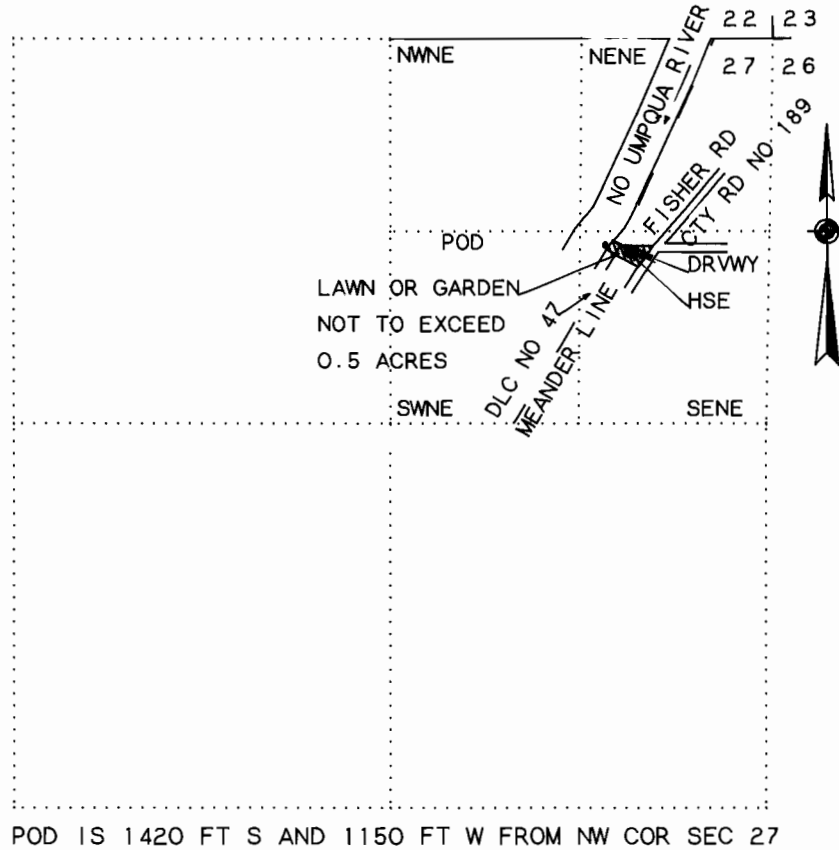

FINAL PROOF SURVEY


UNDER

Application No. 71112 Permit No. 51188

IN NAME OF

SISTERS OF MERCY

Surveyed December 12, 1990 by M E Farr

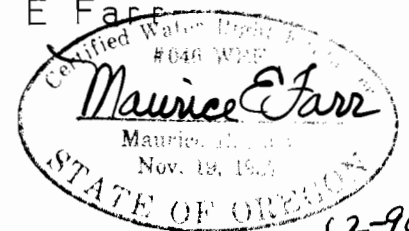

12-90