

DEPARTMENT OF THE INTERIOR
BUREAU OF LAND MANAGEMENT

17-5700
66709

Oregon State Water Filings


A# R 33850

P# R 3705

Cert. Scale 66709

TOWNSHIP 39 S., RANGE 13 E., W. M.

North

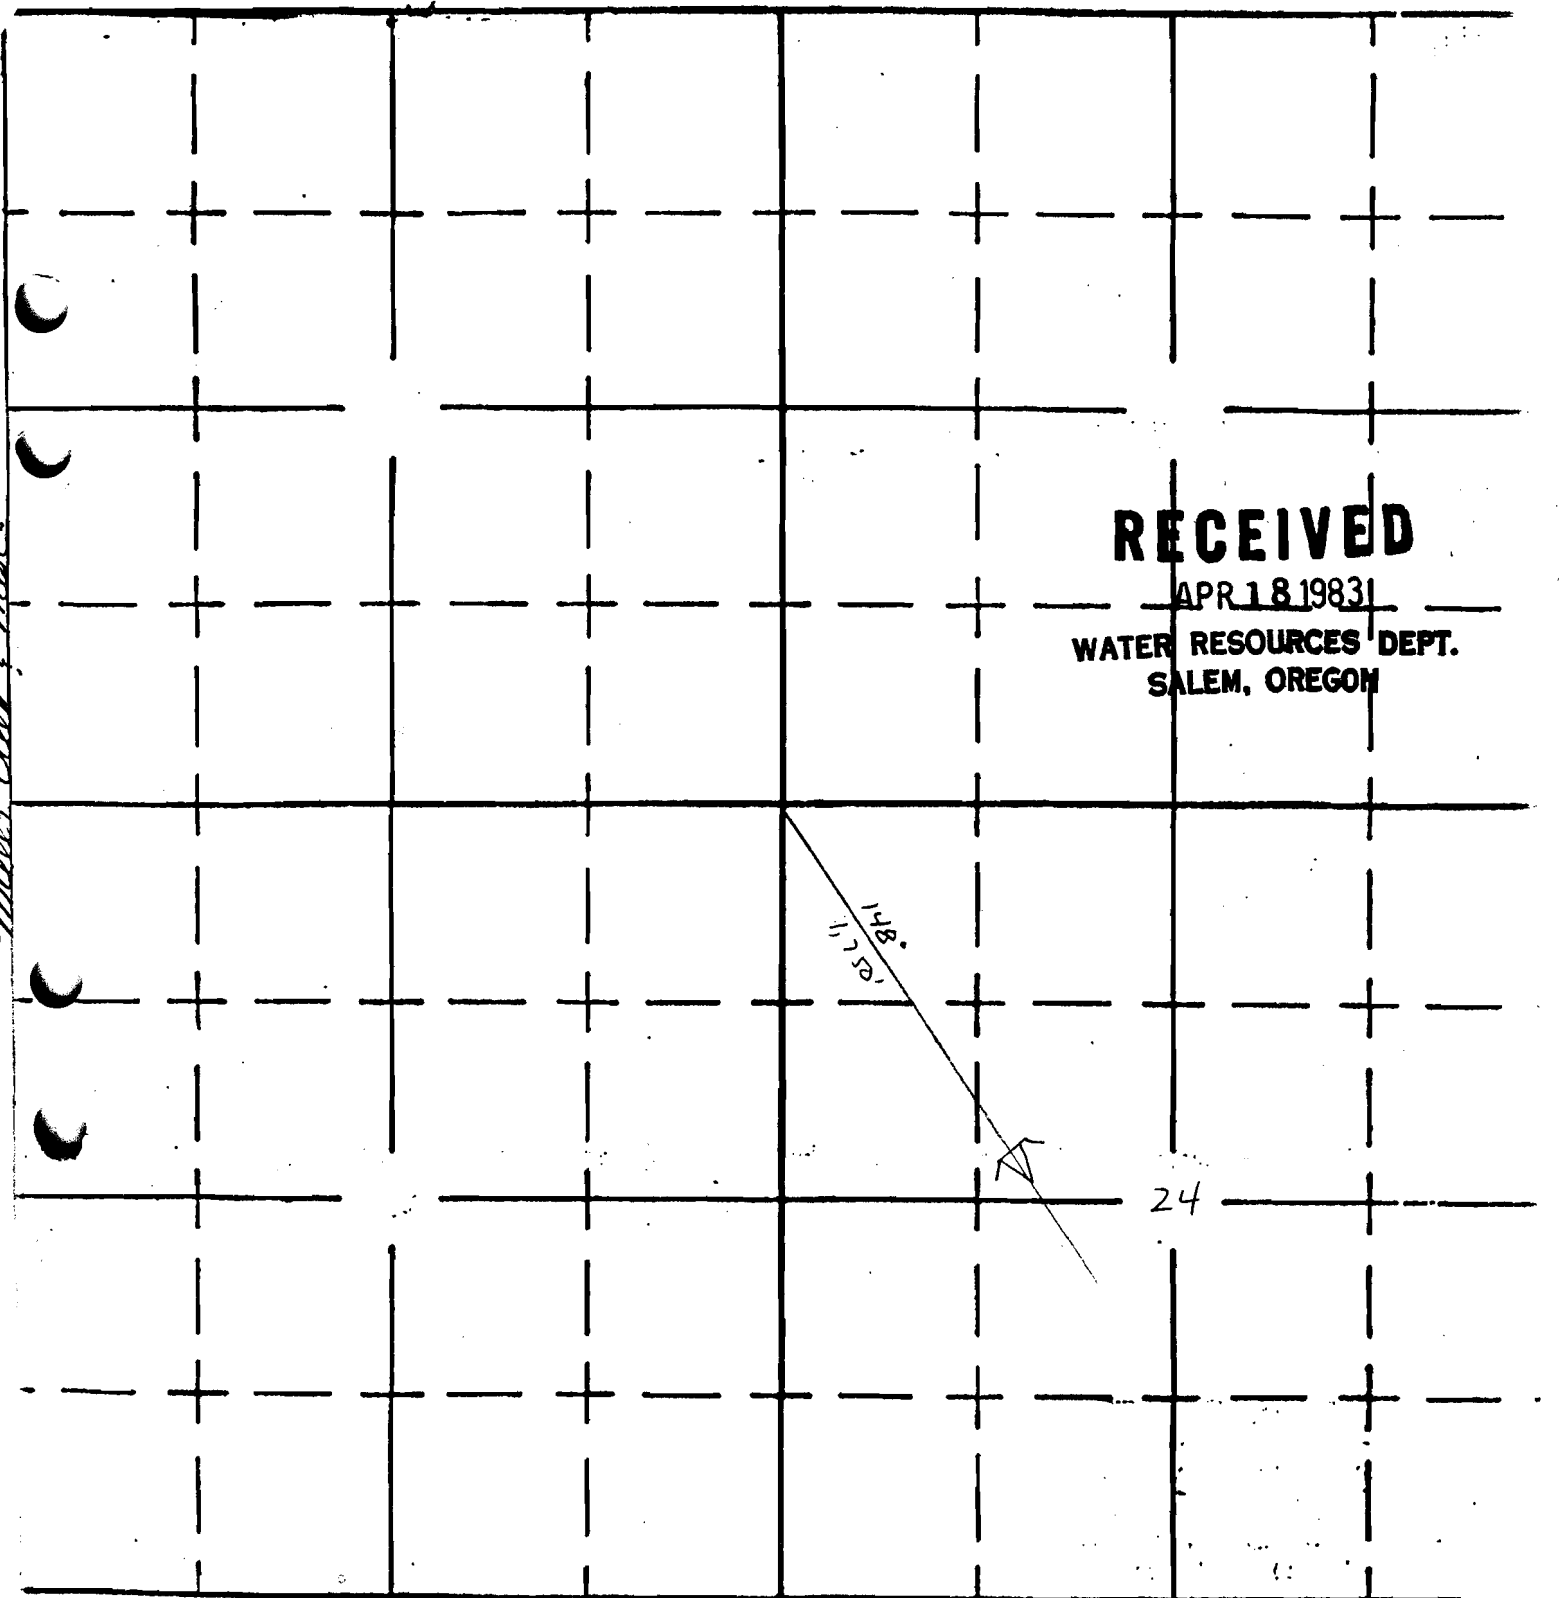

RECEIVED

APR 18 1983

WATER RESOURCES DEPT.
SALEM, OREGON

Memo Book & Misc.

South

APPLICATION No.

PERMIT No.