

Form A1-187
March 1961

UNITED STATES
DEPARTMENT OF THE INTERIOR
BUREAU OF LAND MANAGEMENT

SECTION


NW 1/4 SE 1/4

Sec 29

Oregon State Water Filings

TOWNSHIP 32S, RANGE 36E, W. M.

North

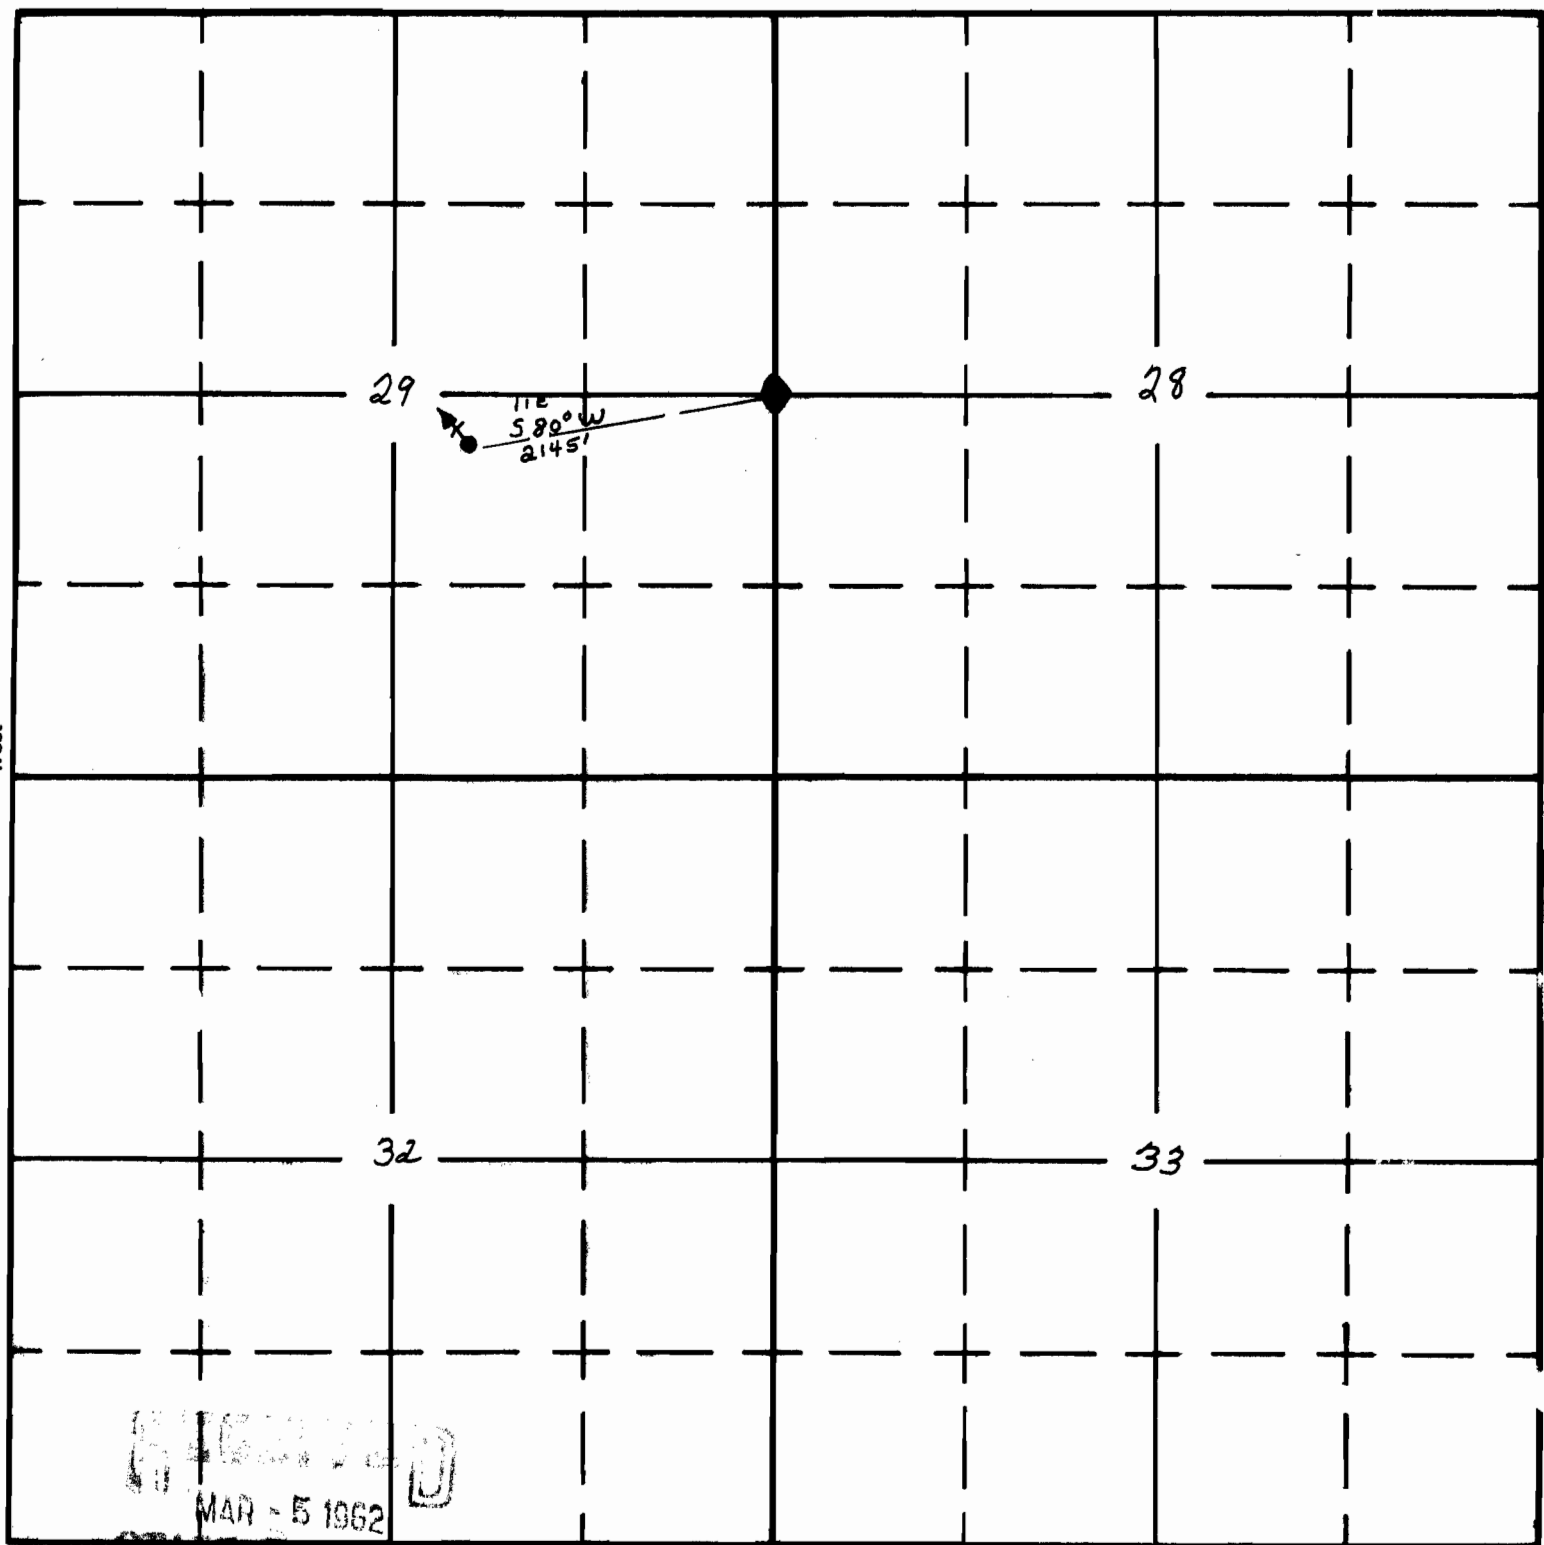

MAR - 5 1962

STATE ENGINEER

South

APPLICATION No. 35388
PERMIT No. 28258