

Form A1-187
March 1961

UNITED STATES
DEPARTMENT OF THE INTERIOR
BUREAU OF LAND MANAGEMENT

SECTION


Oregon State Water Filings

SE $\frac{1}{4}$ SE $\frac{1}{4}$

TOWNSHIP 31S, RANGE 32 $\frac{3}{4}$ E W. M.

Sec. 30

North

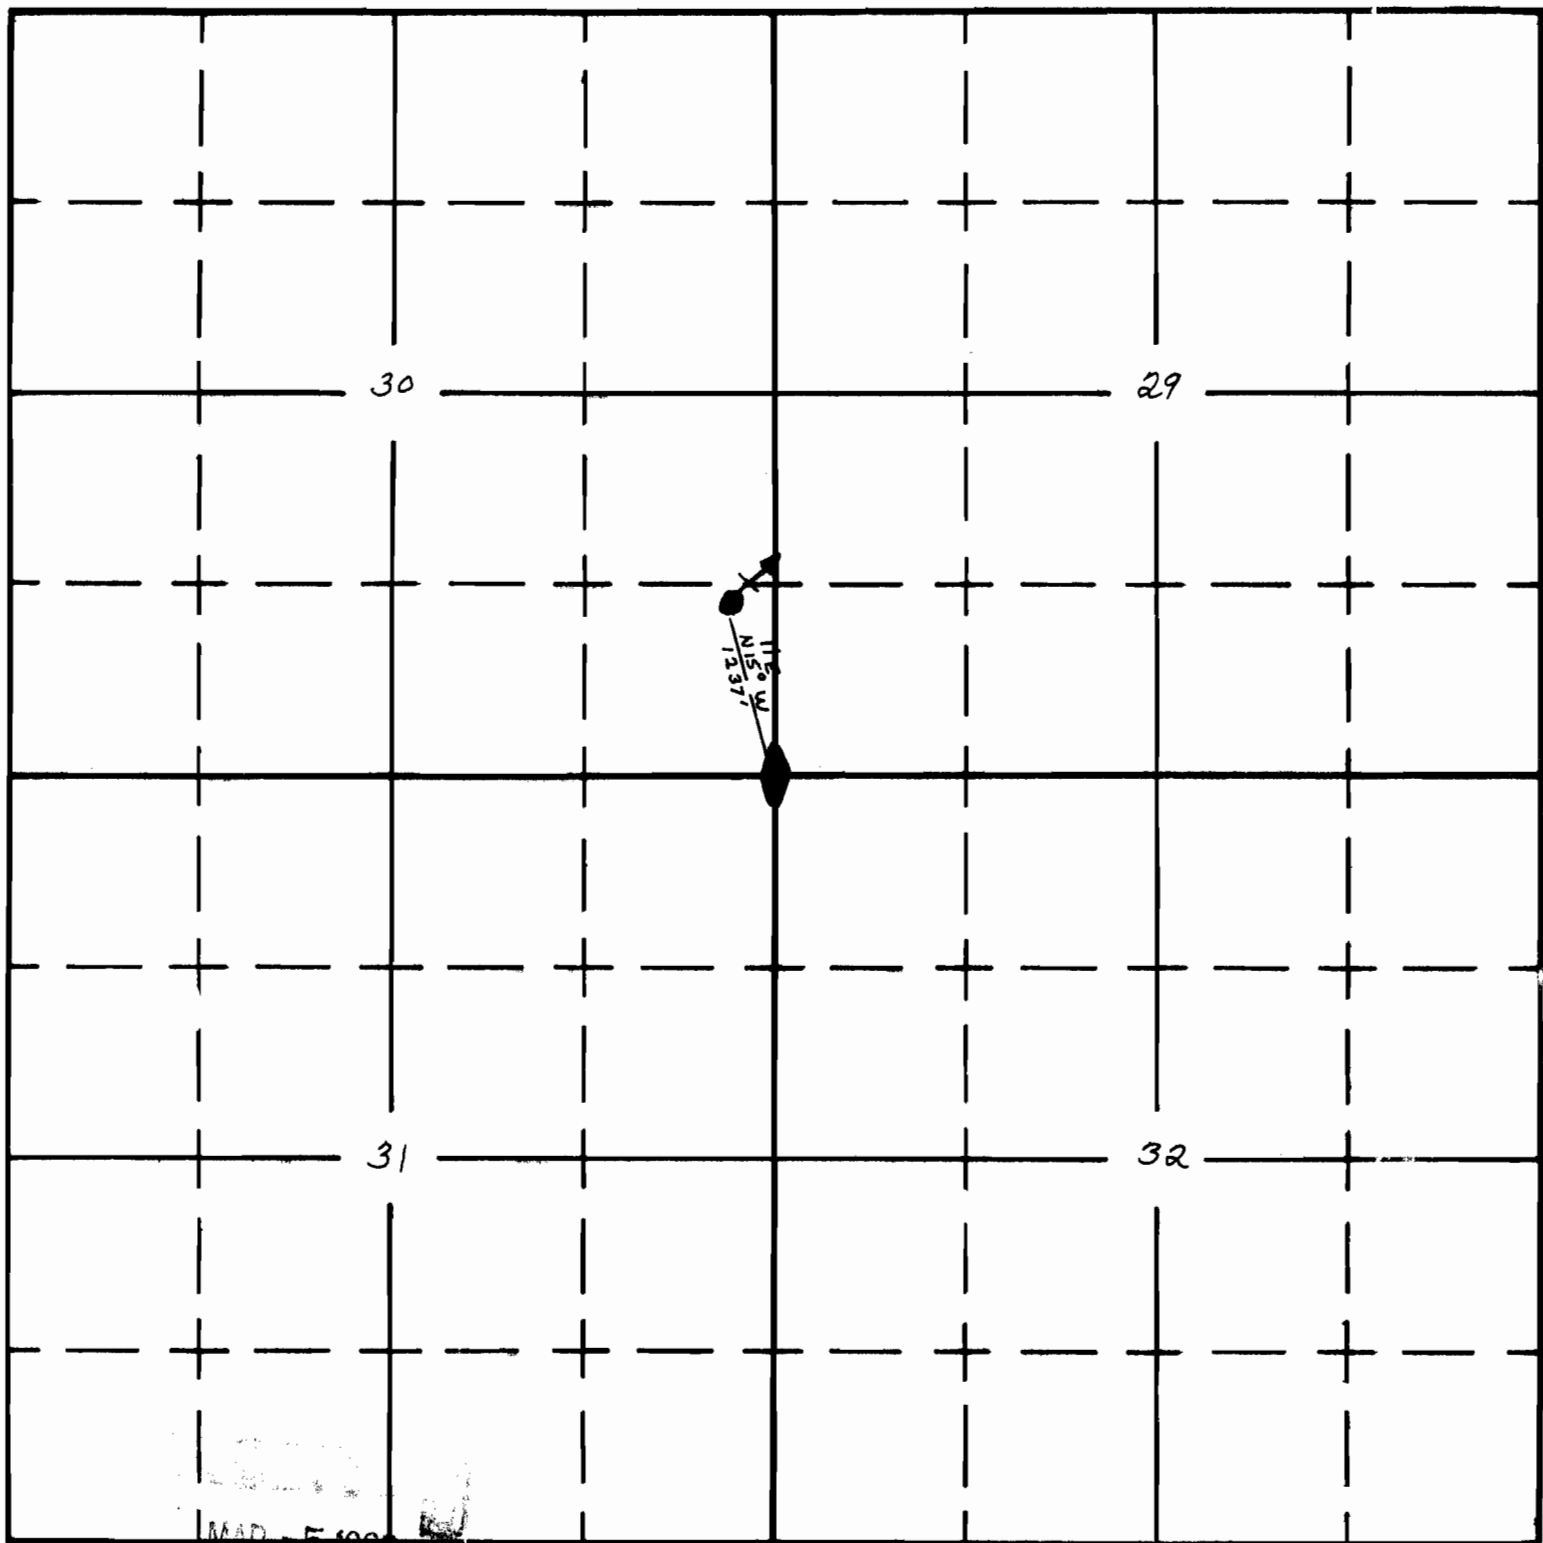

MAR 5 1962

South

APPLICATION No. 35396

PERMIT No. 28264