

Form AI-187
March 1961


UNITED STATES
DEPARTMENT OF THE INTERIOR
BUREAU OF LAND MANAGEMENT

SECTION 20

Oregon State Water Filings

NW 1/4 SW 1/4 TOWNSHIP 38S, RANGE 24E, W. M.

TIED-IN WITH AERIAL PHOTOS AND ^{North} O.S.H.D. QUAD MAPS

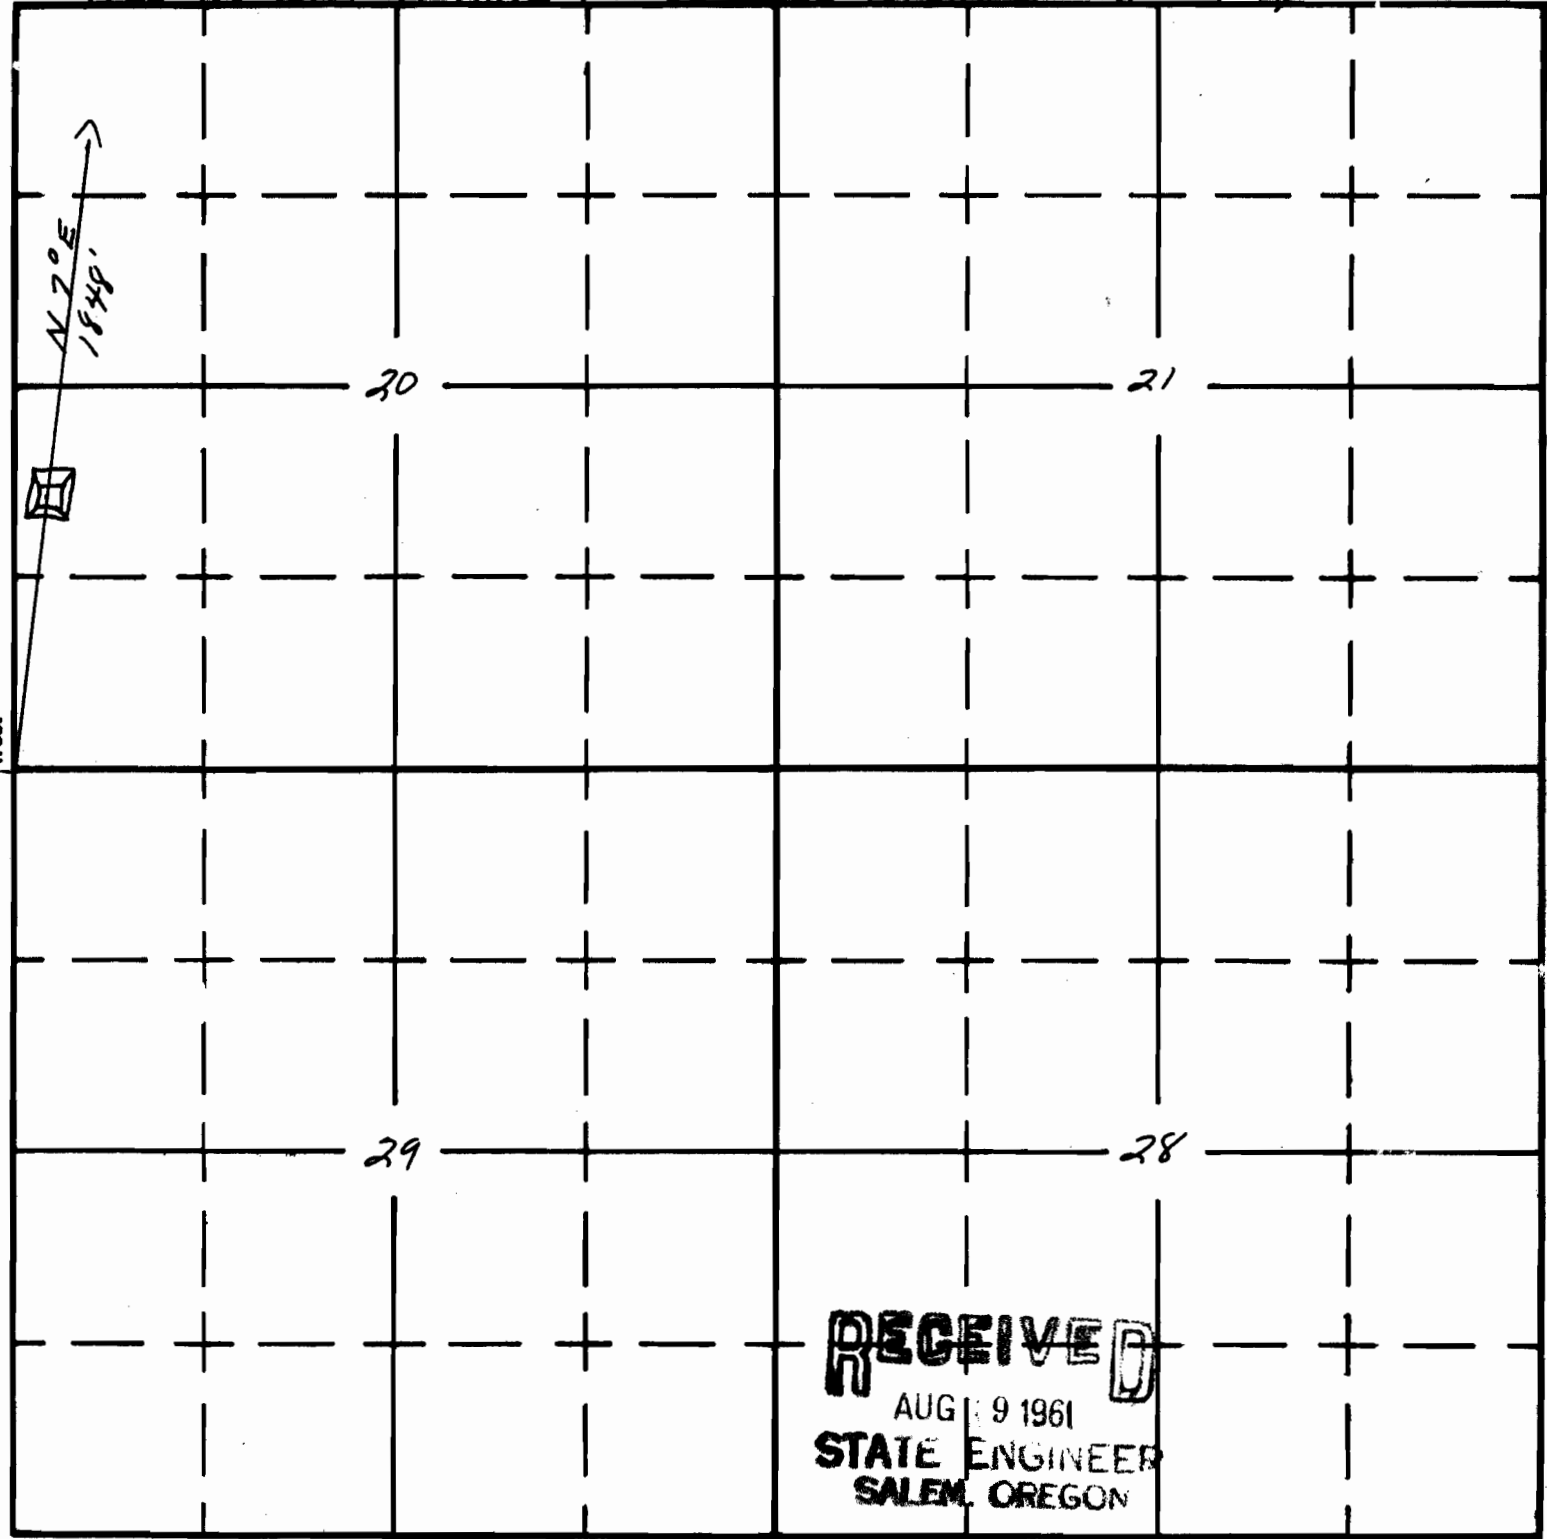

RECEIVED
AUG 9 1961
STATE ENGINEER
SALEM, OREGON

South

APPLICATION No. R-36941
PERMIT No. R-4377