

UNITED STATES
DEPARTMENT OF THE INTERIOR
BUREAU OF LAND MANAGEMENT


SECTION 36

Oregon State Water Filings

NE NE

TOWNSHIP 28^S, RANGE 45^E, W. M.

North Goodyear.

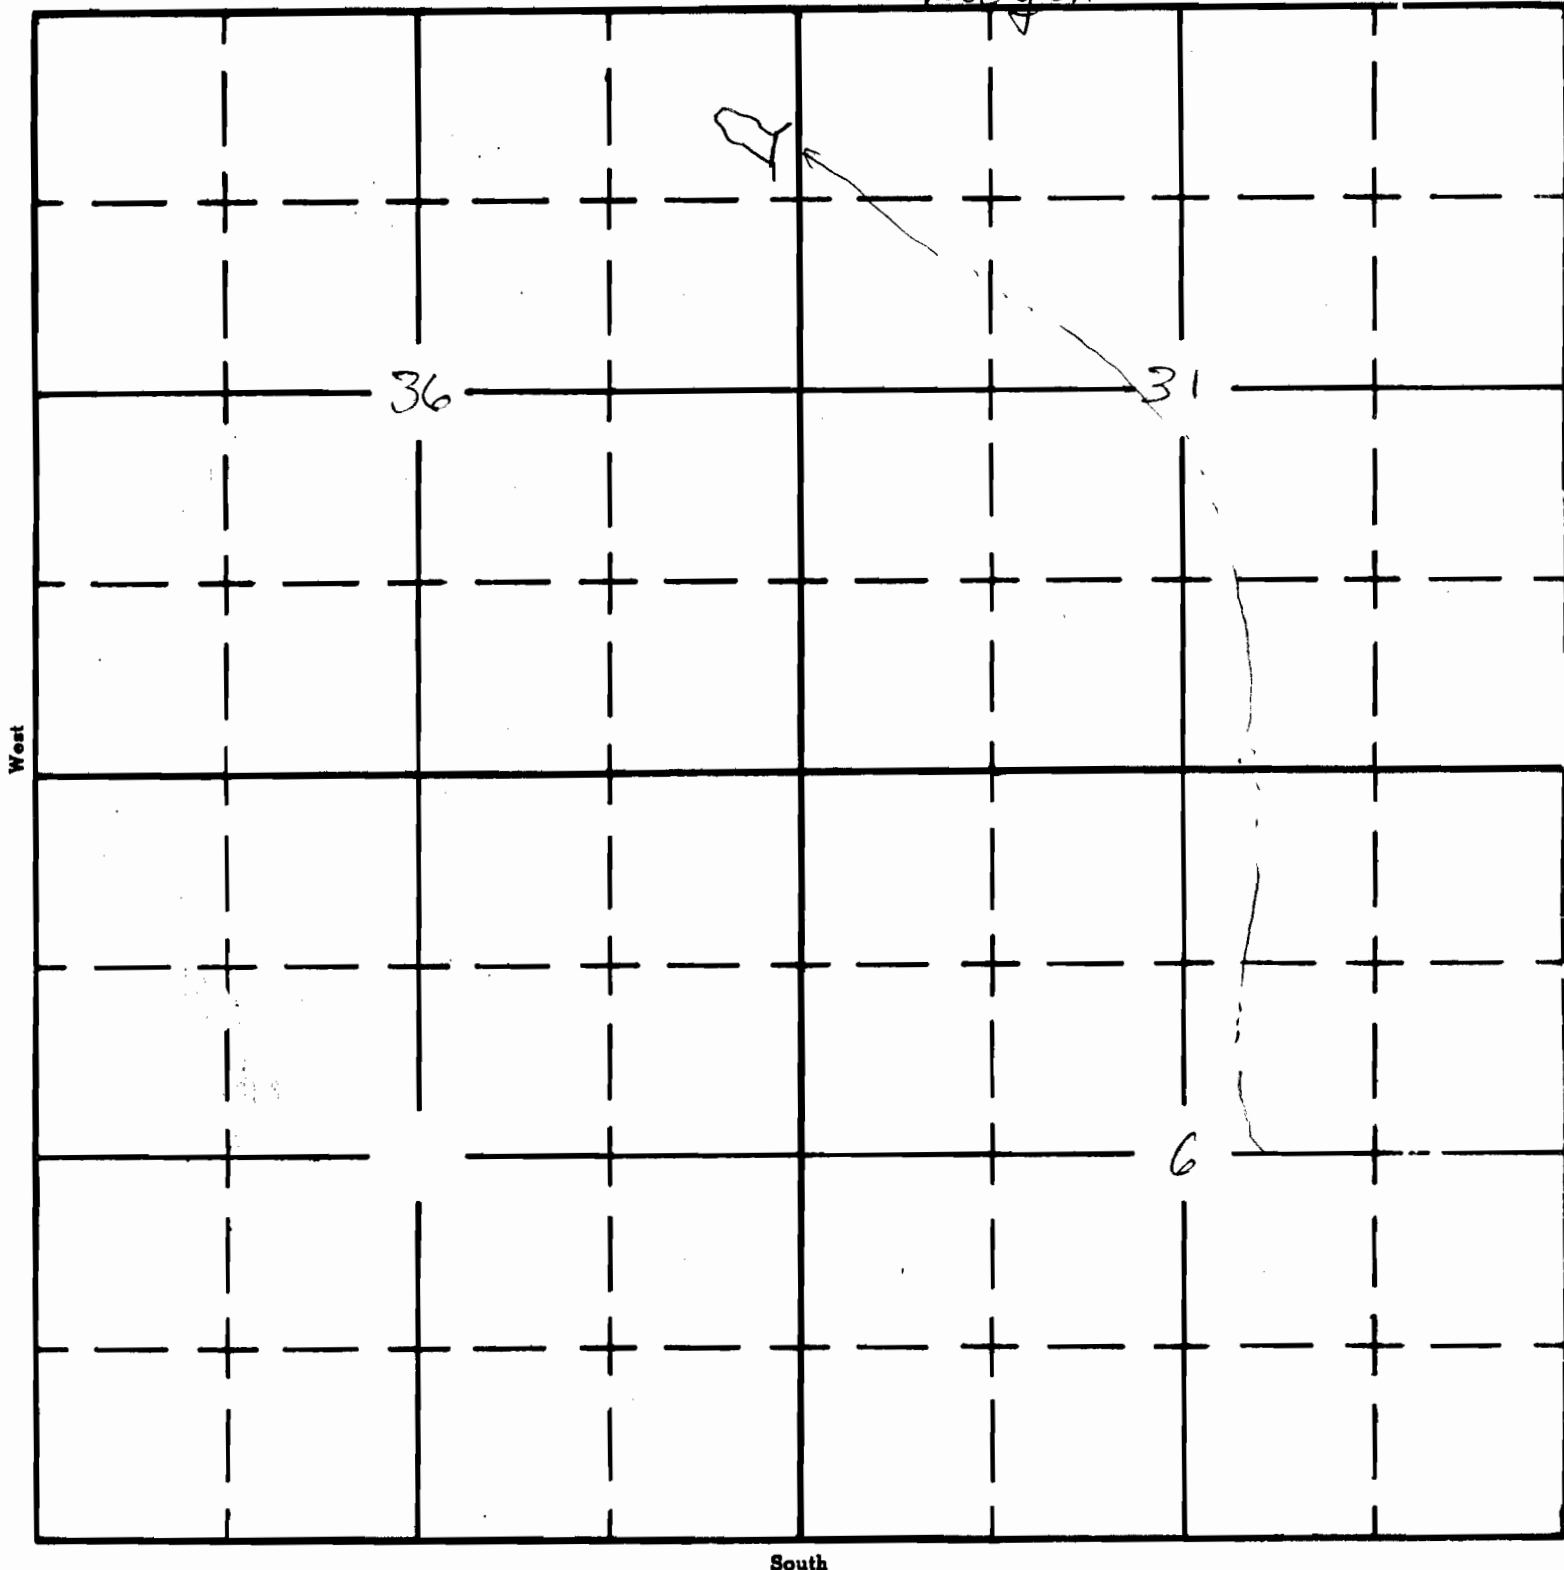

UNITED STATES
DEPARTMENT OF THE INTERIOR
BUREAU OF LAND MANAGEMENT

SECTION

Oregon State Water Filings

531

TOWNSHIP 28S, RANGE 46E, W. M.

