

P-7114-1
Nov. 1965

UNITED STATES
DEPARTMENT OF THE INTERIOR
BUREAU OF LAND MANAGEMENT

SECTION


Oregon State Water Filings

Rogers

21
SE 1/4 NW 4

TOWNSHIP 39S, RANGE 23E, W. M.

North

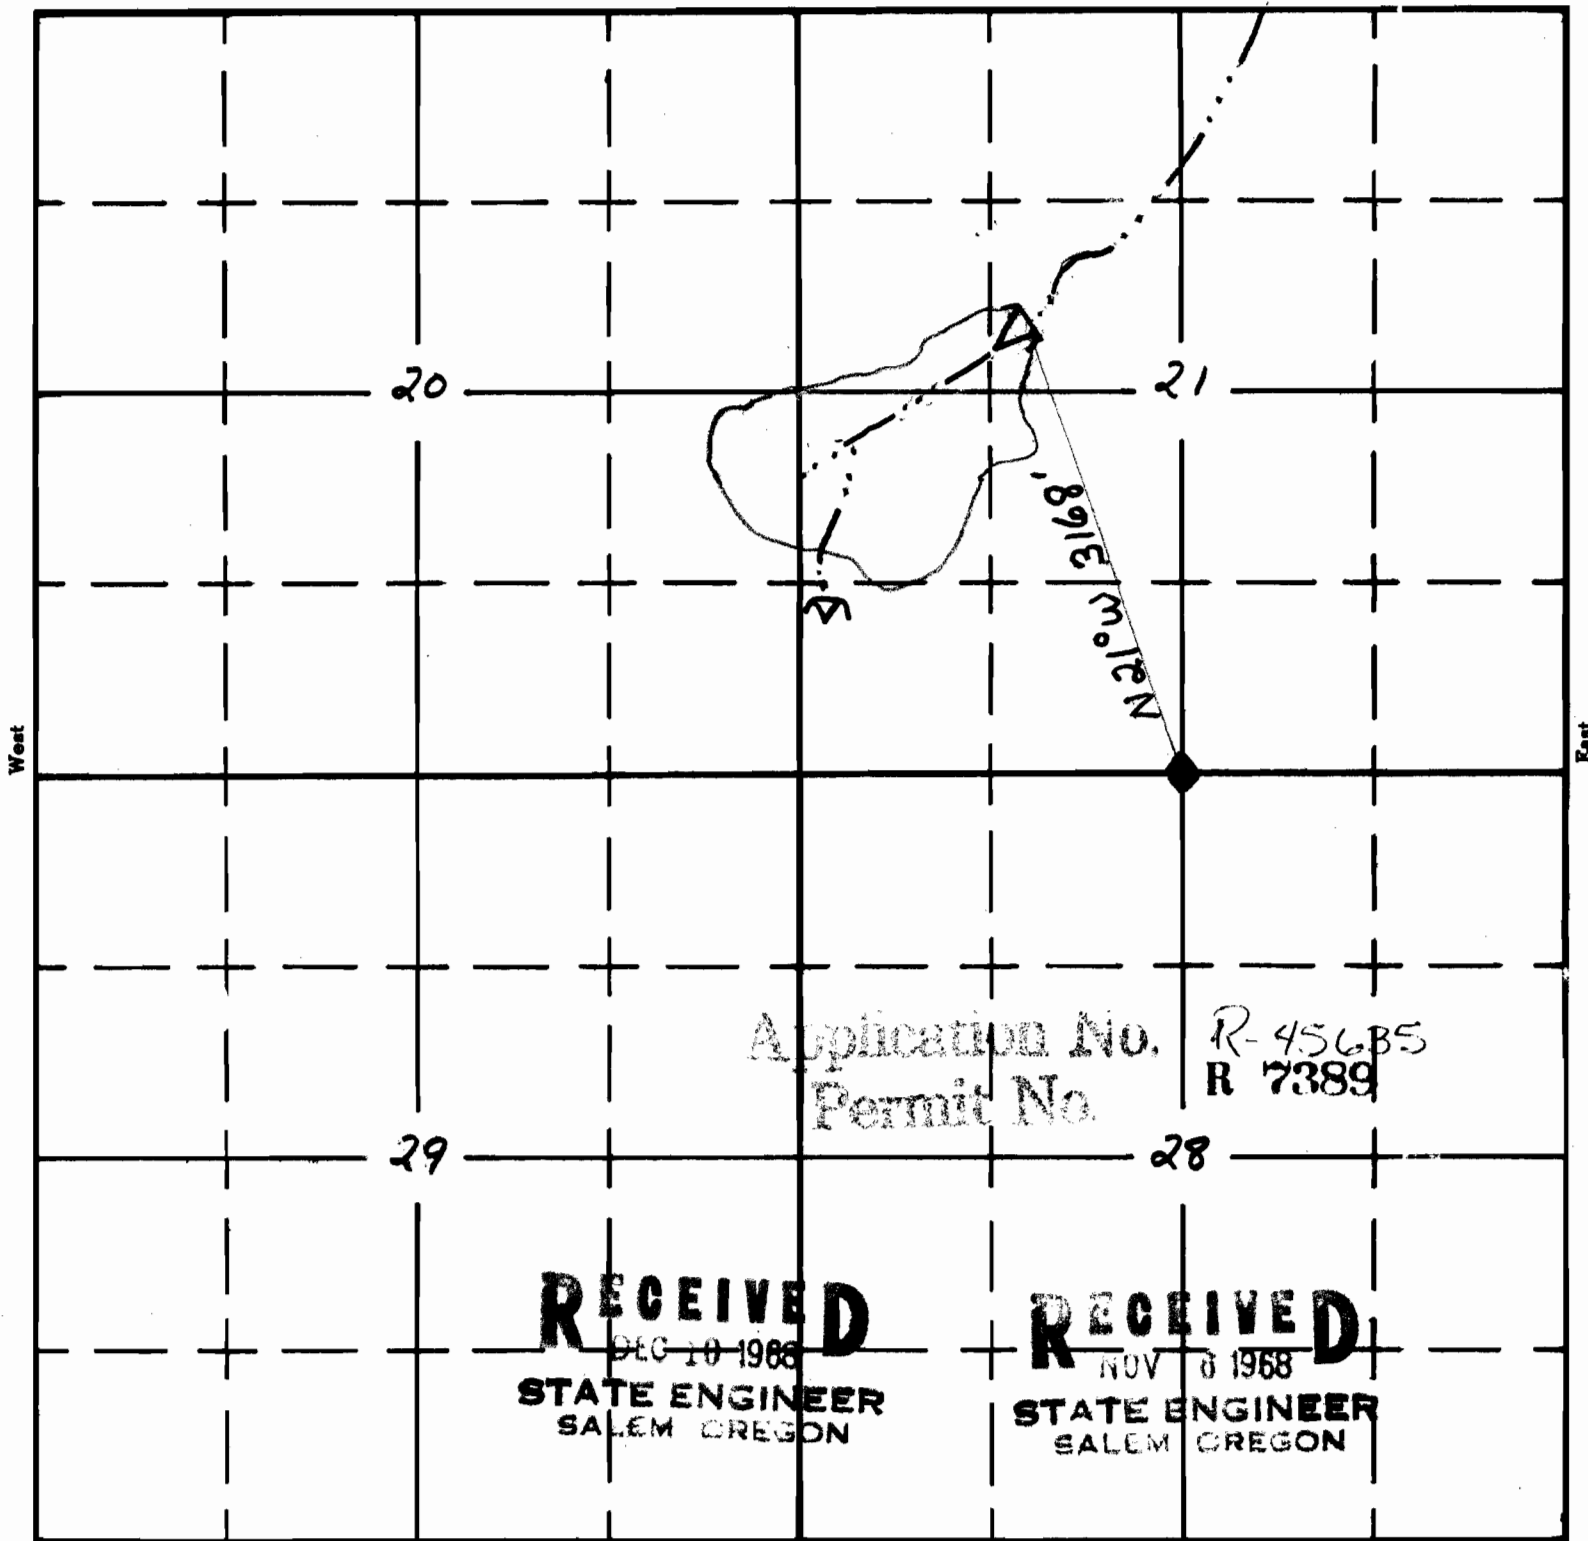

South

——— watershed boundary

APPLICATION No.
PERMIT No.