


2-11099
LL72

T4N, R28E, W.M., Umatilla Co., OR. FINAL PROOF SURVEY


Under Permit G-11099
Application G-12040

In the name of: Earl Stewart Rt. 5, Box 5560
Hermiston, Oregon 97838 Phone: 567-8211

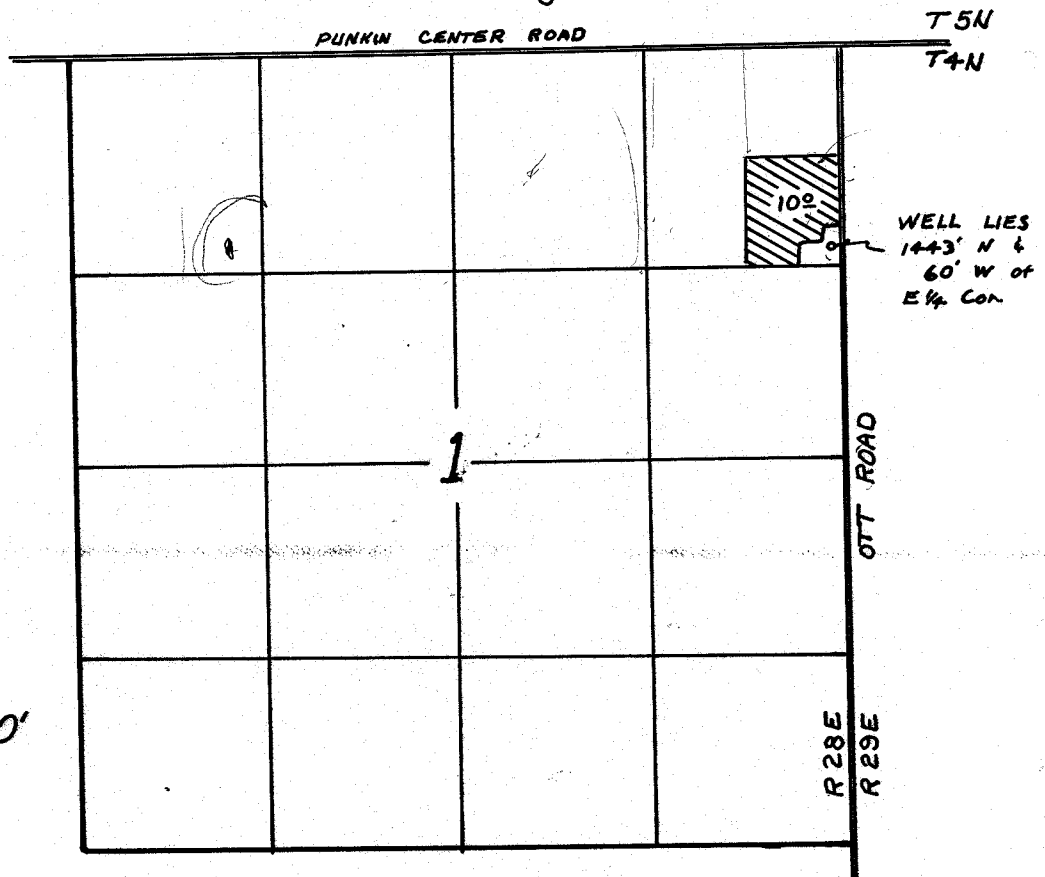

Scale: 1"=1320'

This map is for identifying the location of water rights only and is not intended to show property lines or dimensions.

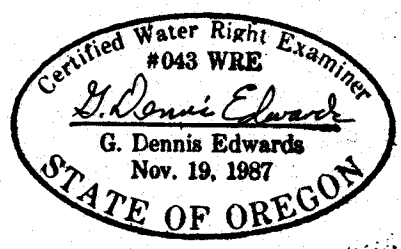

4/11/91 Job # W9002010-F
Edwards Surveying P.O. Box 763
567-3336 Hermiston, OR. 97838