

Harney
CO.

Applic. # 63138
Permit # 48884

STINK SPGS 01-5123

REIMERS, R. ANDERSON, ROWEN


NOTES

ONE CRIB

160' PIPE

REROUTE DRAINAGE AROUND HEMLOCK ; DIKE TO
PROTECT

LOTS OF JUNIPERS w/ DRAINAGE

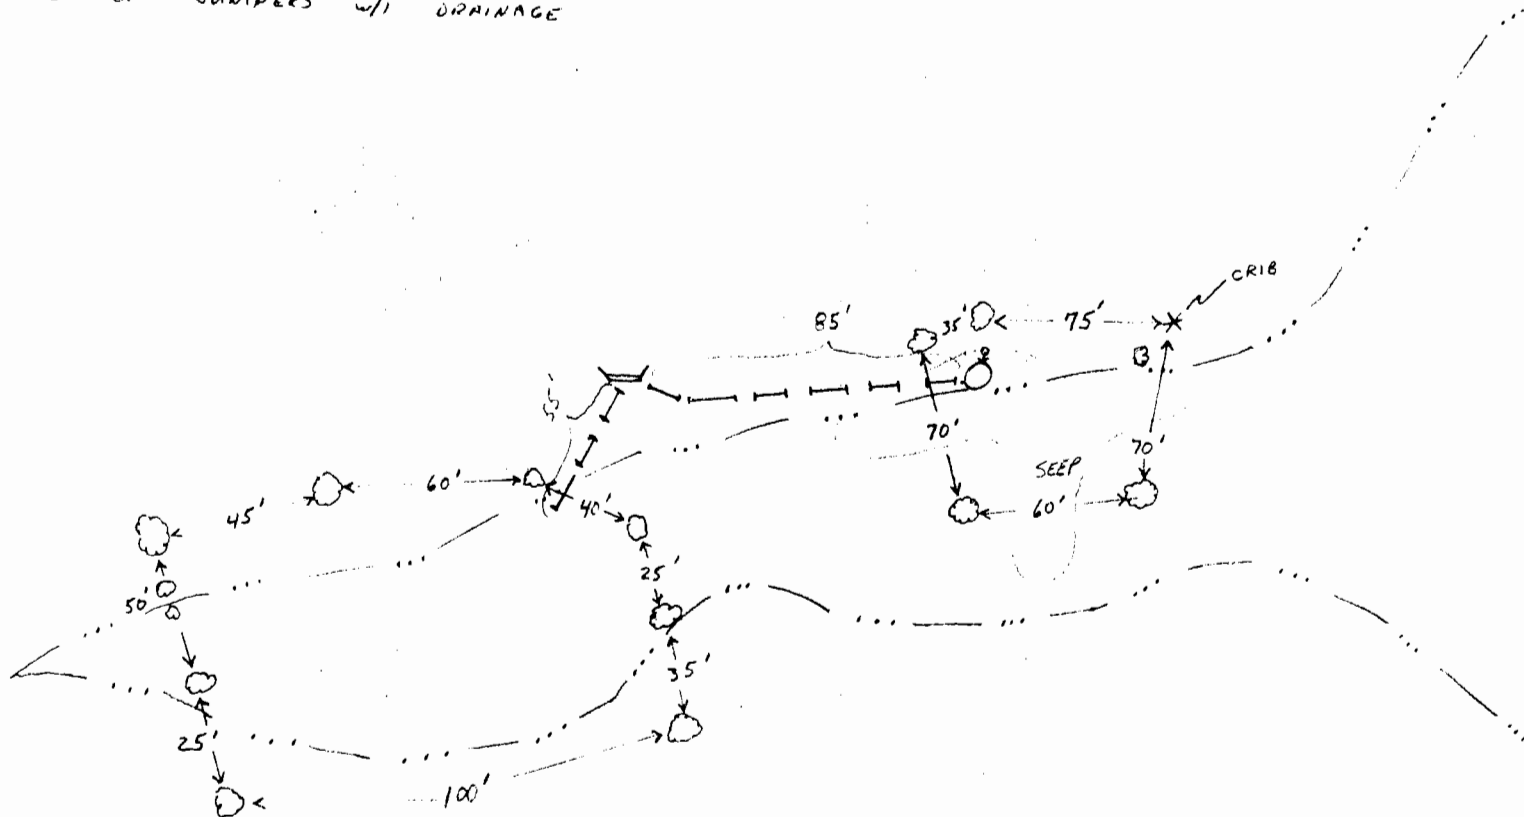

UNITED STATES
DEPARTMENT OF THE INTERIOR
BUREAU OF LAND MANAGEMENT

Snake Spring " 5773

ON 16
SENE

Oregon State Water Filings **RECEIVED**


TOWNSHIP 21 S, RANGE 36 E, W. M.

DEC 14 1981

WATER RESOURCES DEPT.
SALEM, OREGON

North

Application No. 63138
Permit No. 48884

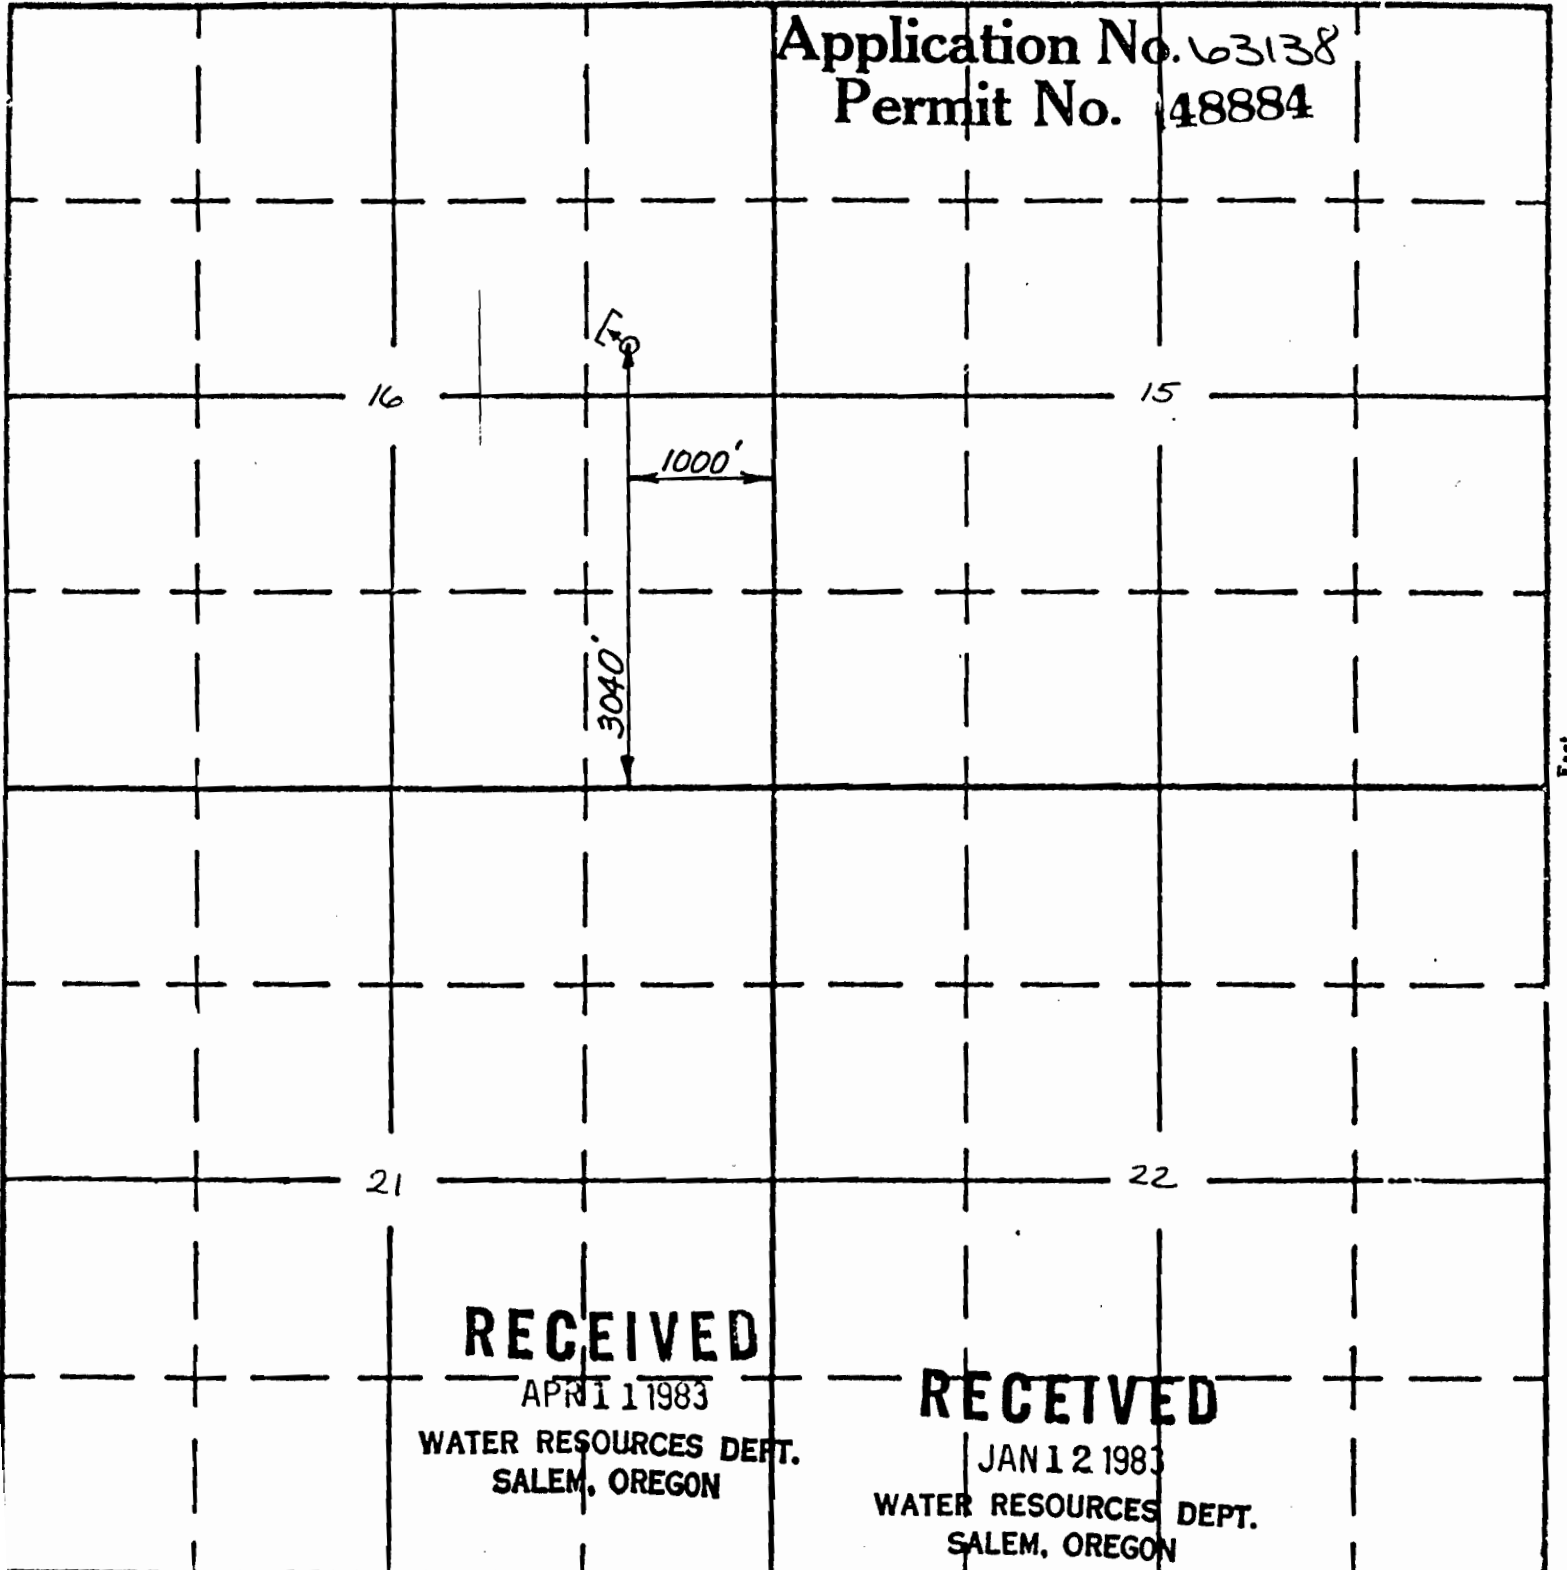

RECEIVED

APR 11 1983

WATER RESOURCES DEPT.
SALEM, OREGON

RECEIVED

JAN 12 1983

WATER RESOURCES DEPT.
SALEM, OREGON

APPLICATION No.