
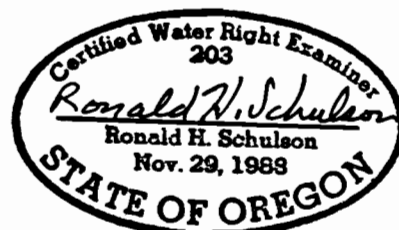


FINAL PROOF SURVEY

T. 5 S., T. 6 W., W.M.

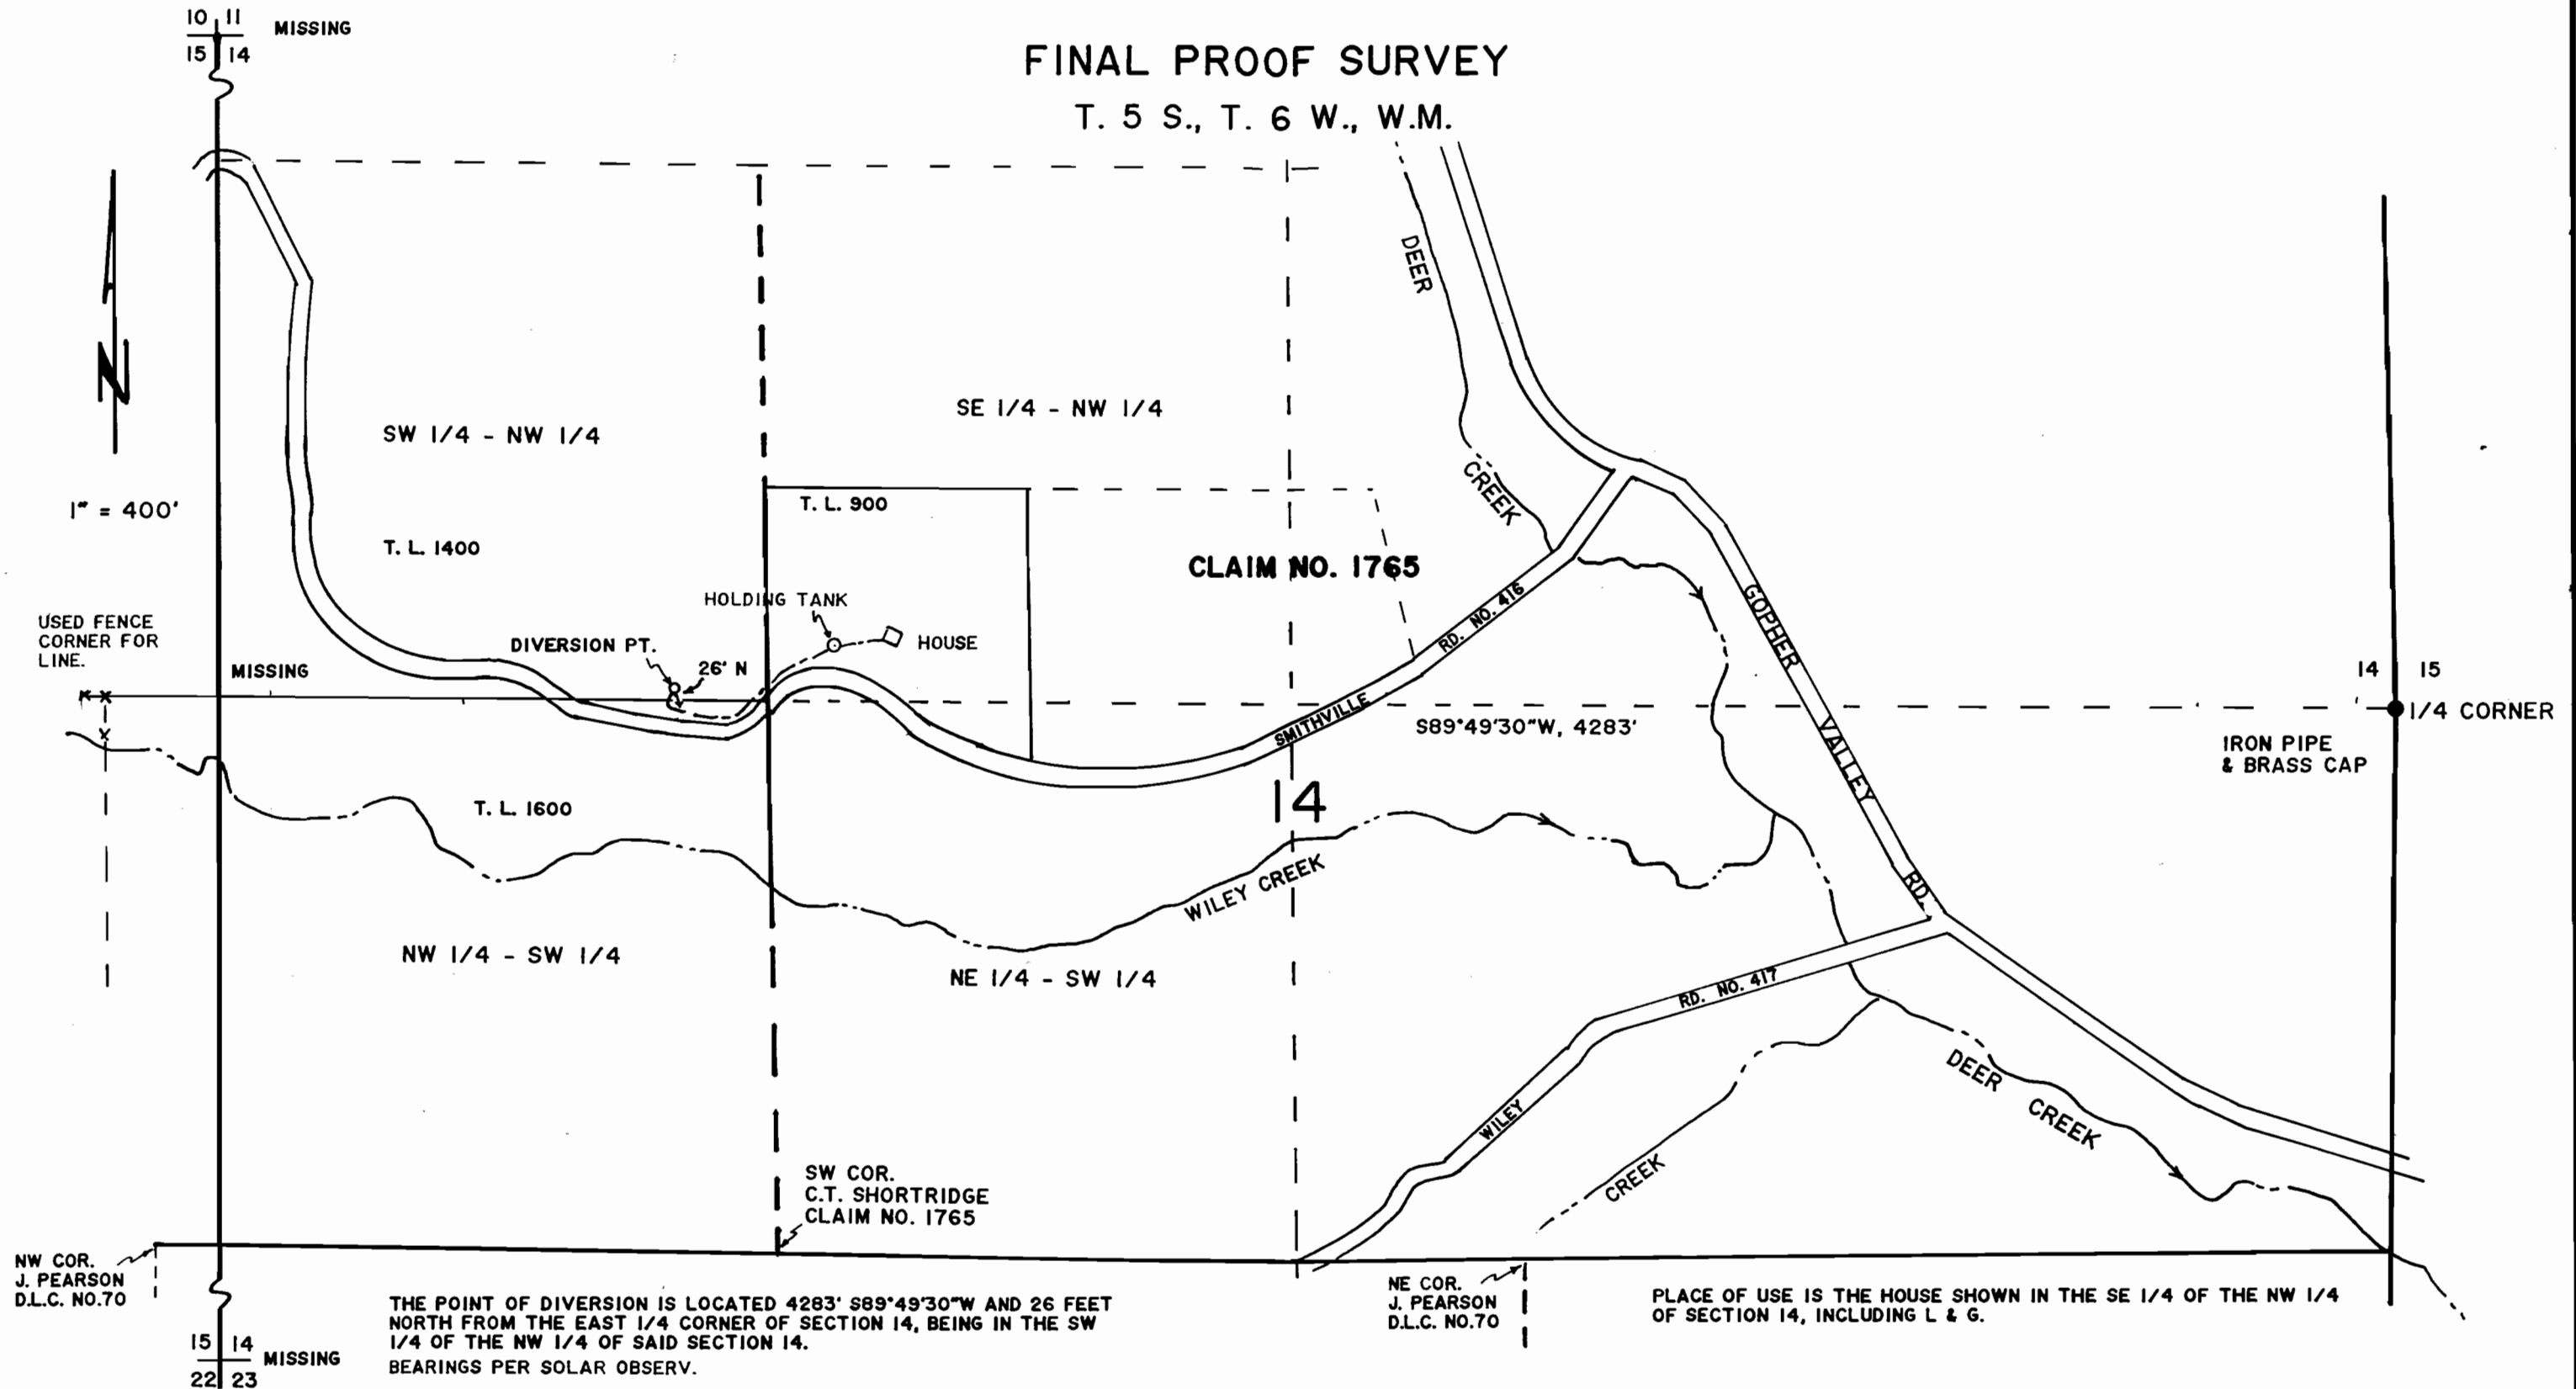

APPLICATION NO. 70137
UNDER

PERMIT NO. 50985

GARY J. AND TERRI A. CROWE

SURVEYED MARCH 13, 1991, BY RHS

J & R SURVEYORS - P.O. BOX 418 - DALLAS, OR 97338 - PH. 623-4003

NOTE: MAP IS FOR THE PURPOSE OF IDENTIFYING
LOCATION OF WATER RIGHT AND HAS NO INTENT TO
DIMENSION OR LOCATE PROPERTY OWNERSHIP LINES.