

T. 30 S., R. 12 W., W.M.
 FINAL PROOF SURVEY



Application No. 70394

Permit No. 51145

In name of Robert E. & Olene Vencill

Surveyed June 13, 1991 by: Forrest J. Hales

1" = 400 ft.

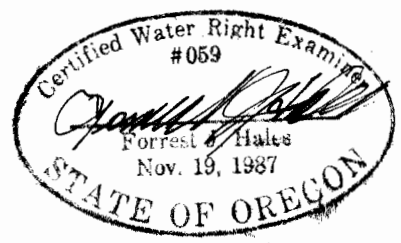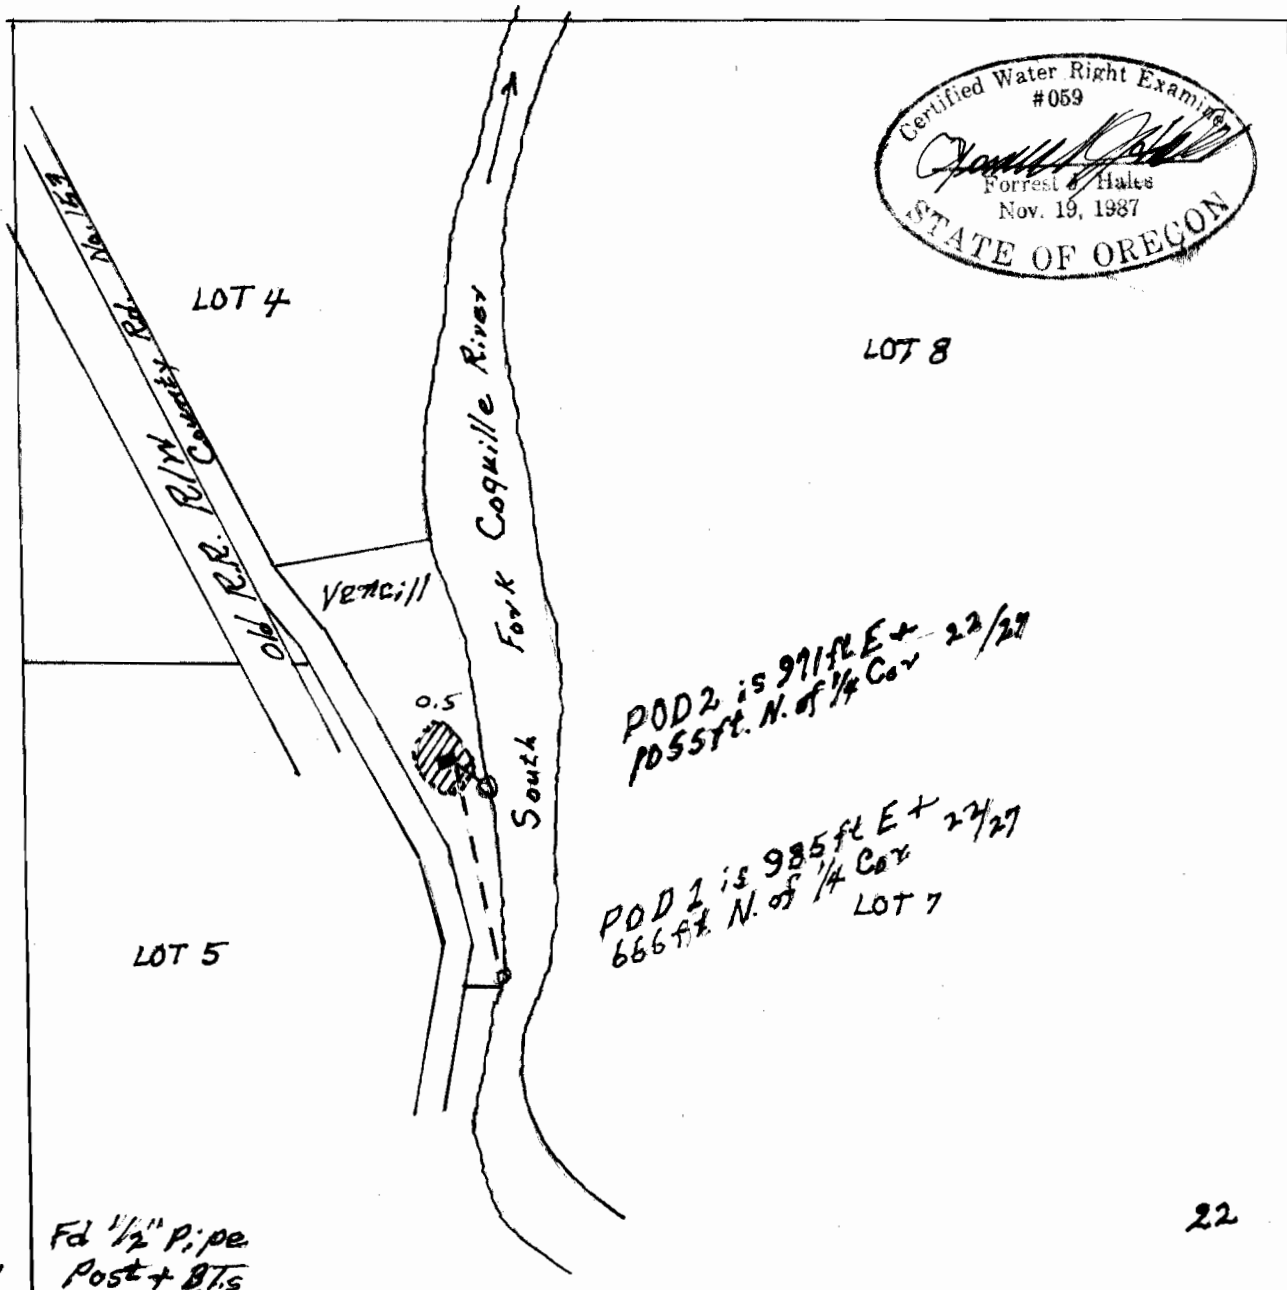

22 Fd 1/2" Pipe Post + B.T.s

22 23

27

27

26

F.J. Hales 6-15-91