


RECEIVED

SEP 11 1981

WATER RESOURCES DEPT
SALEM, OREGON

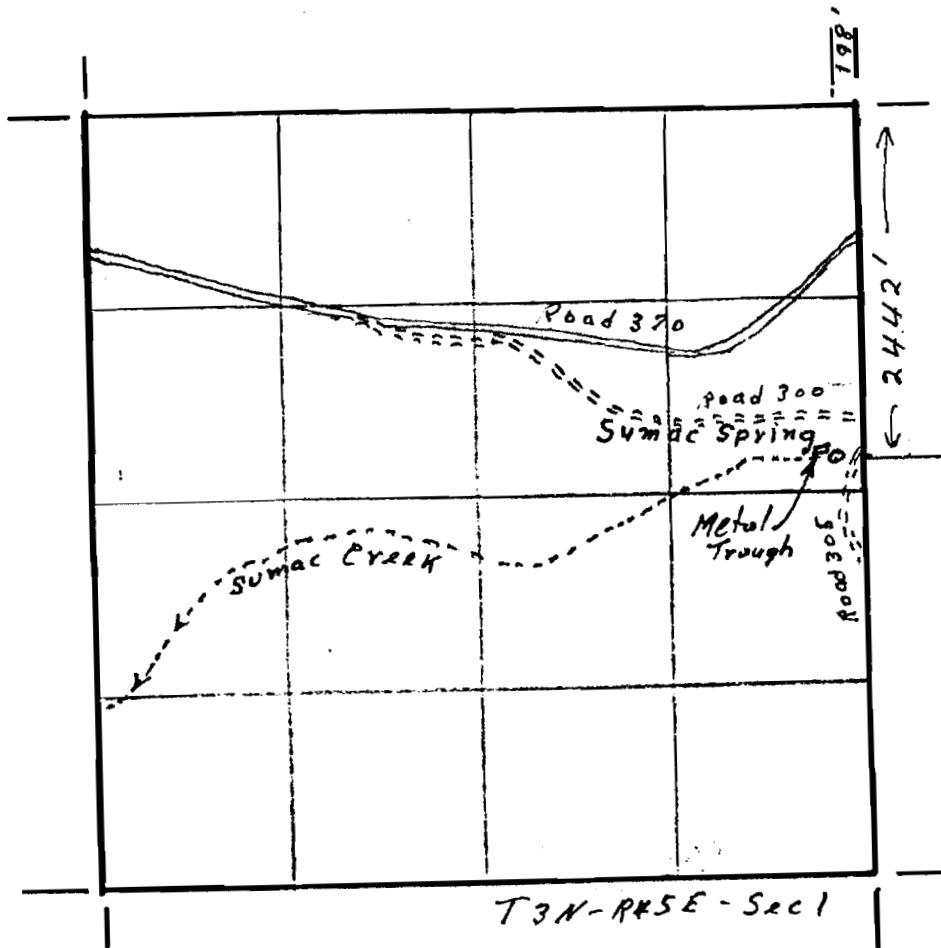

4 Inches = 1 Mile

Application No. 62651

Permit No. 46729