


RECEIVED

SEP 11 1981

WATER RESOURCES DEPT
SALEM, OREGON

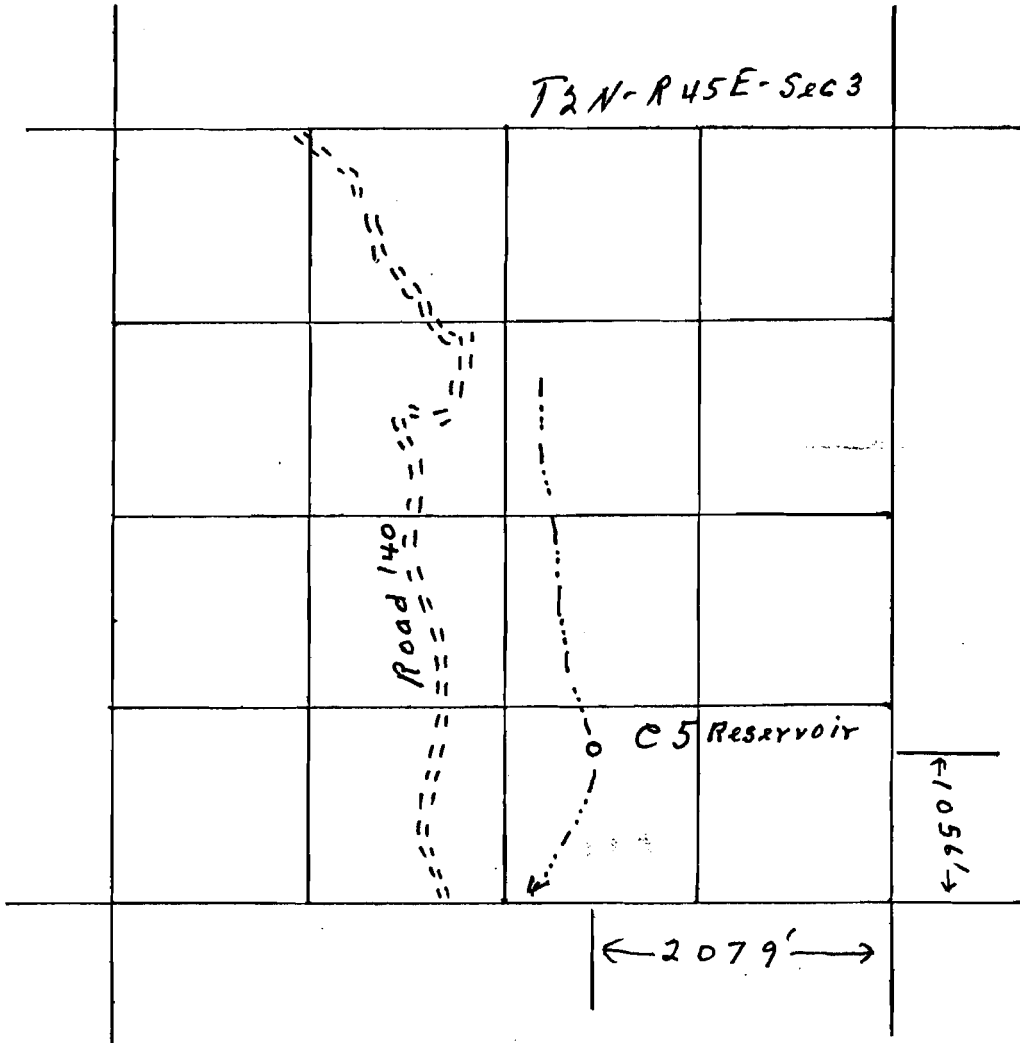

Application No. R-62653
Permit No. R 8414

4 inches = 1 mile