


RECEIVED

SEP 11 1981

WATER RESOURCES DEPT
DALEM, OREGON

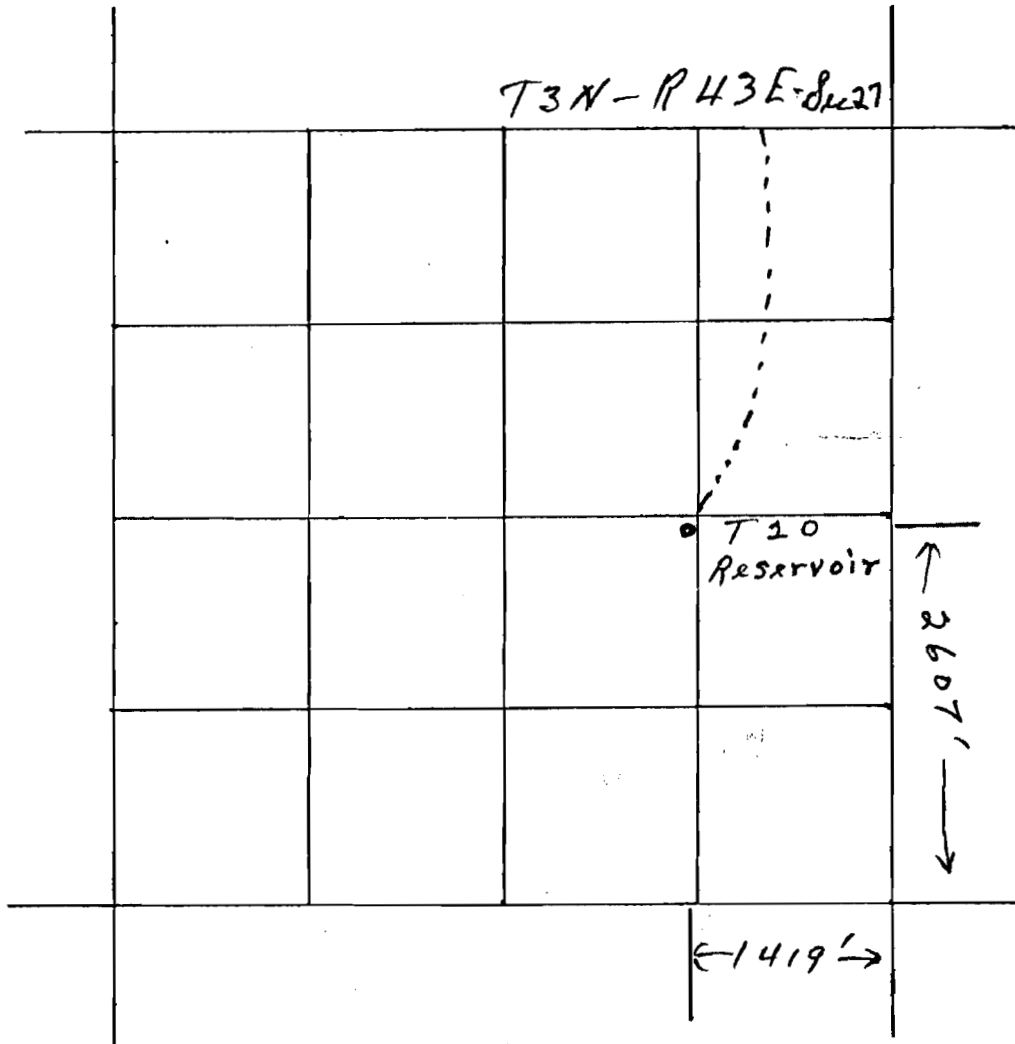

Application No. R-62656

Permit No. R 8417

4 inches = 1 mile