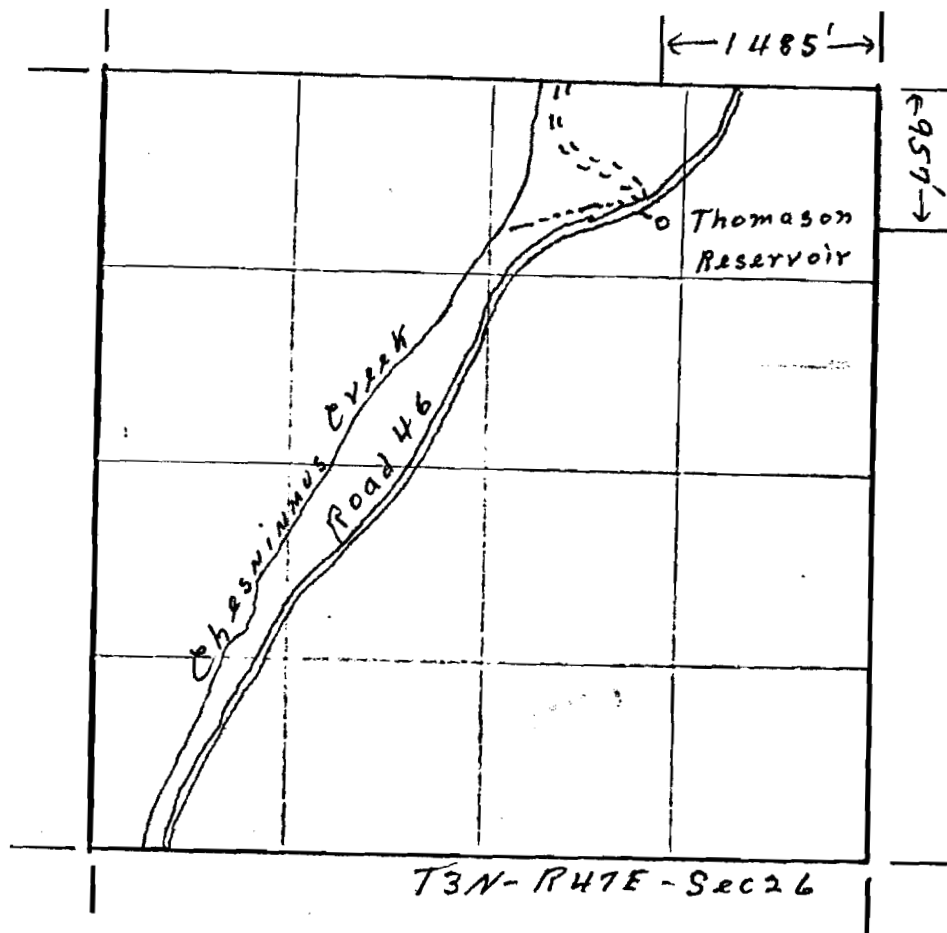


RECEIVED

SEP 11 1981

WATER RESOURCES DEPT  
SALEM, OREGON

4 Inches = 1 Mile

Application No. R-62659  
Permit No. R 8420