


RECEIVED

SEP 11 1981

WATER RESOURCES DEPT
SALEM, OREGON

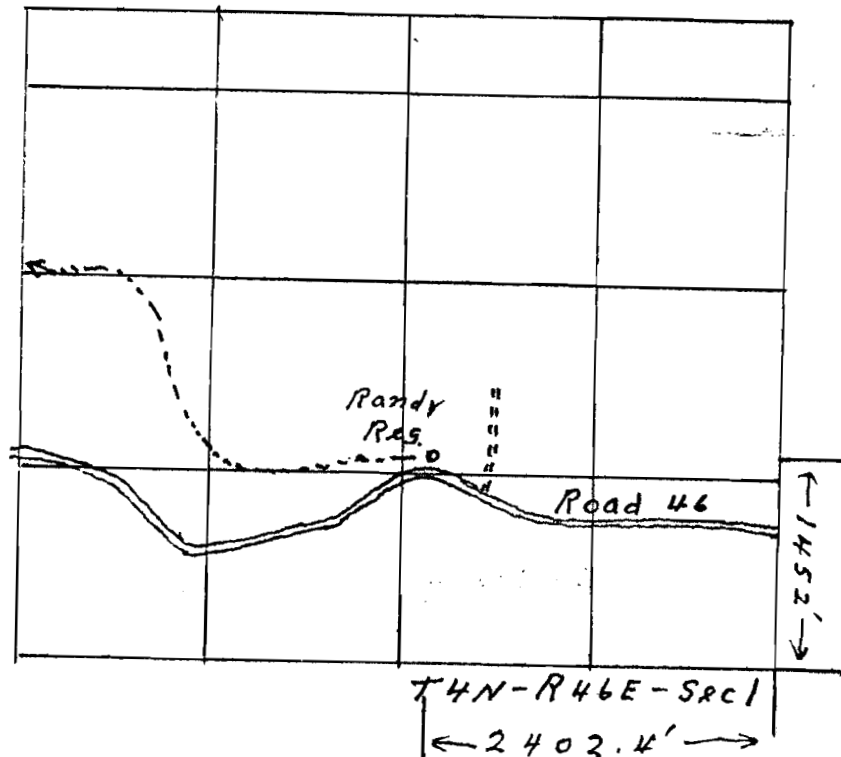

4 INCHES = 1 MILE

Application No. R-62667

Permit No. R 8428