


RECEIVED

SEP 11 1981

WATER RESOURCES DEPT
SALEM, OREGON

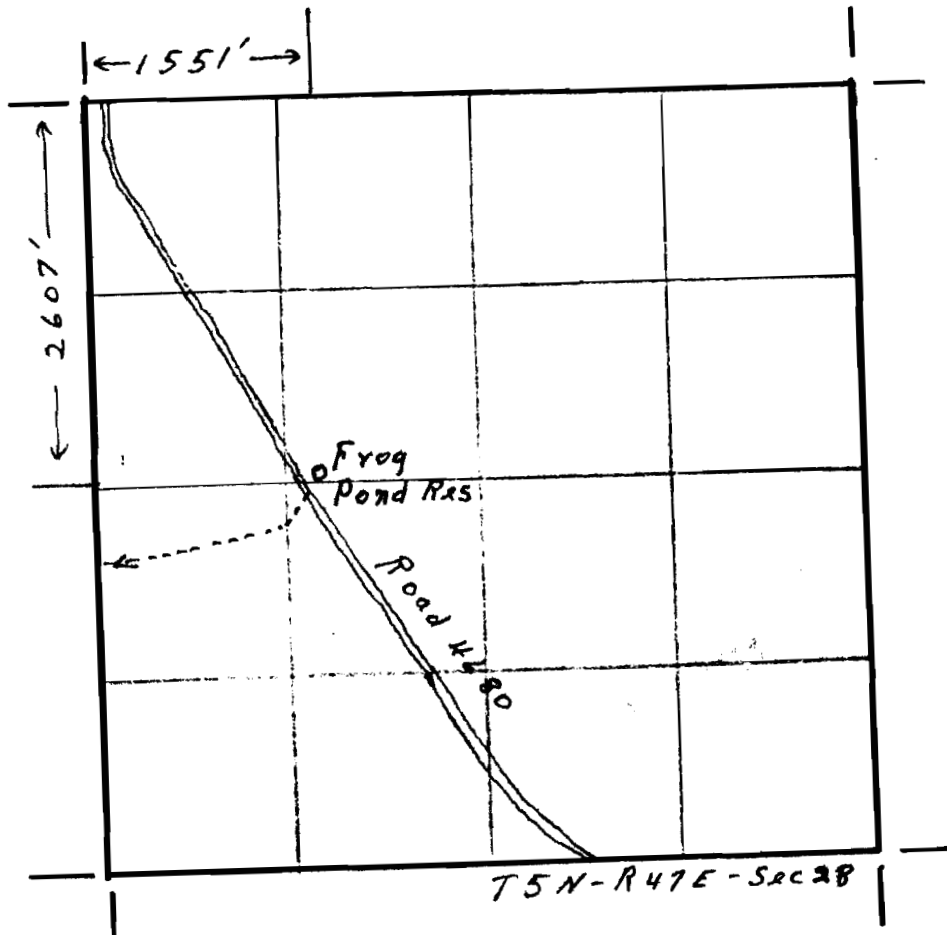

4 Inches = 1 Mile

Application No. R-62670
Permit No. R 8431