

UNITED STATES
DEPARTMENT OF THE INTERIOR
BUREAU OF LAND MANAGEMENT

SECTION


NE $\frac{1}{4}$ Sw $\frac{1}{4}$

Sec 29

Oregon State Water Filings

TOWNSHIP 39S, RANGE 32E, W. M.

North

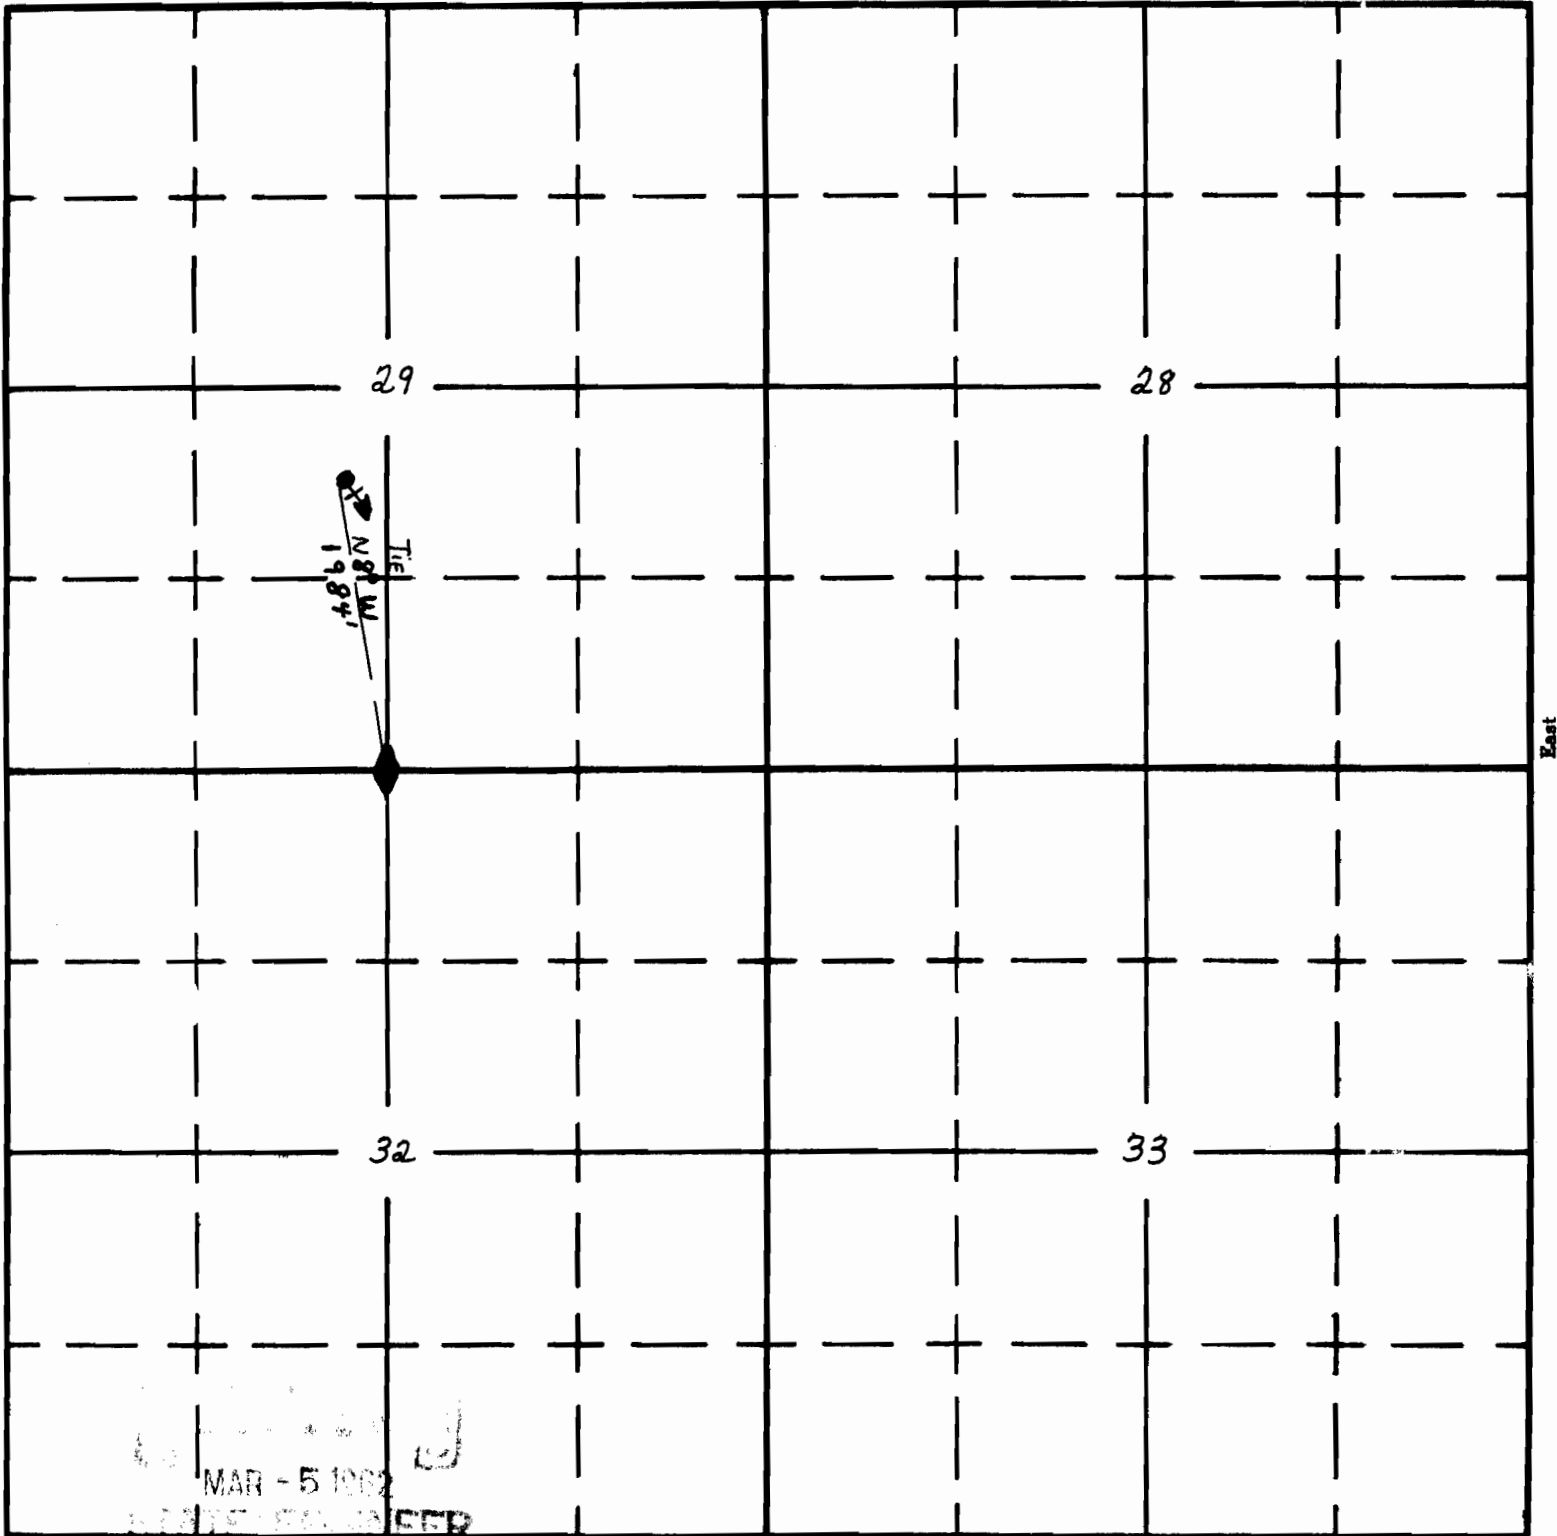

MAR - 5 1962

APPLICATION No. 35400
PERMIT No. 28915