


RECEIVED

SEP 11 1981

WATER RESOURCES DEPT
SALEM, OREGON

W/11/1981

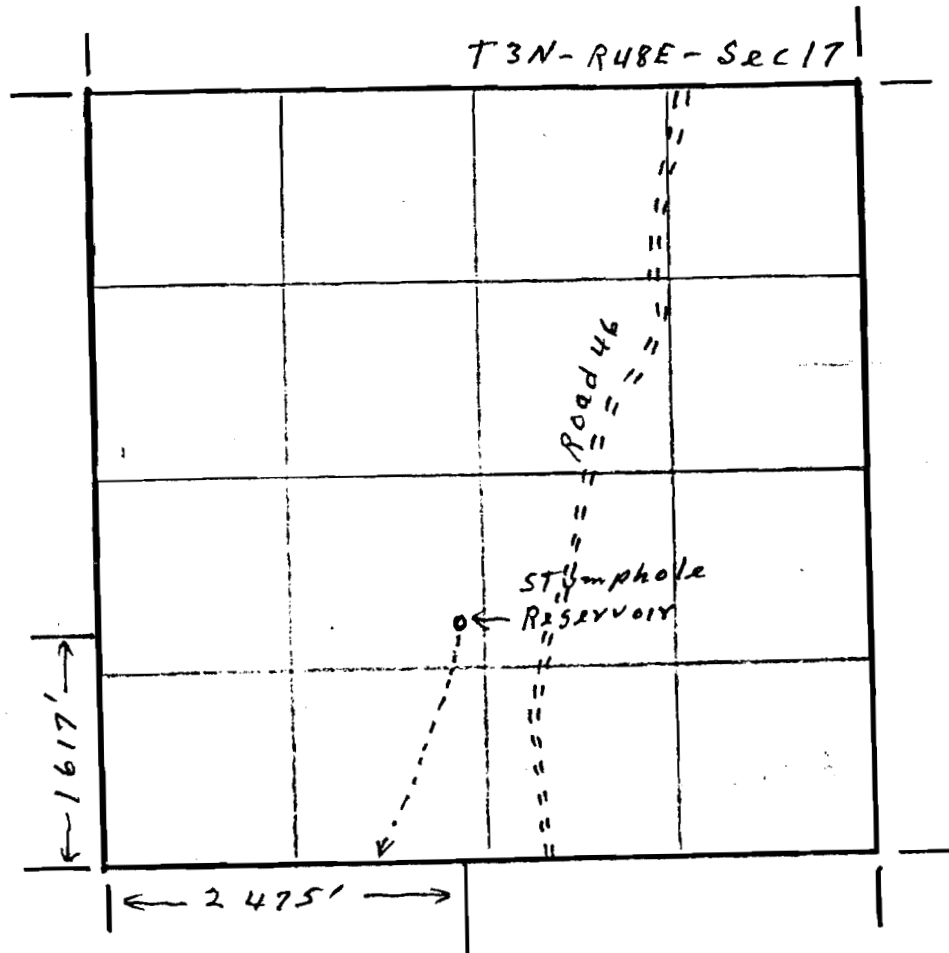

4 Inches = 1 Mile

Application No. R-62657

Permit No. R 8418