

UNITED STATES
DEPARTMENT OF THE INTERIOR
BUREAU OF LAND MANAGEMENT


SECTION
36

Oregon State Water Filings

TOWNSHIP 13 S., RANGE 44 E., W. M.

RECEIVED
MARCH 1961
BUREAU OF LAND MANAGEMENT
WASHINGTON, D. C.

North

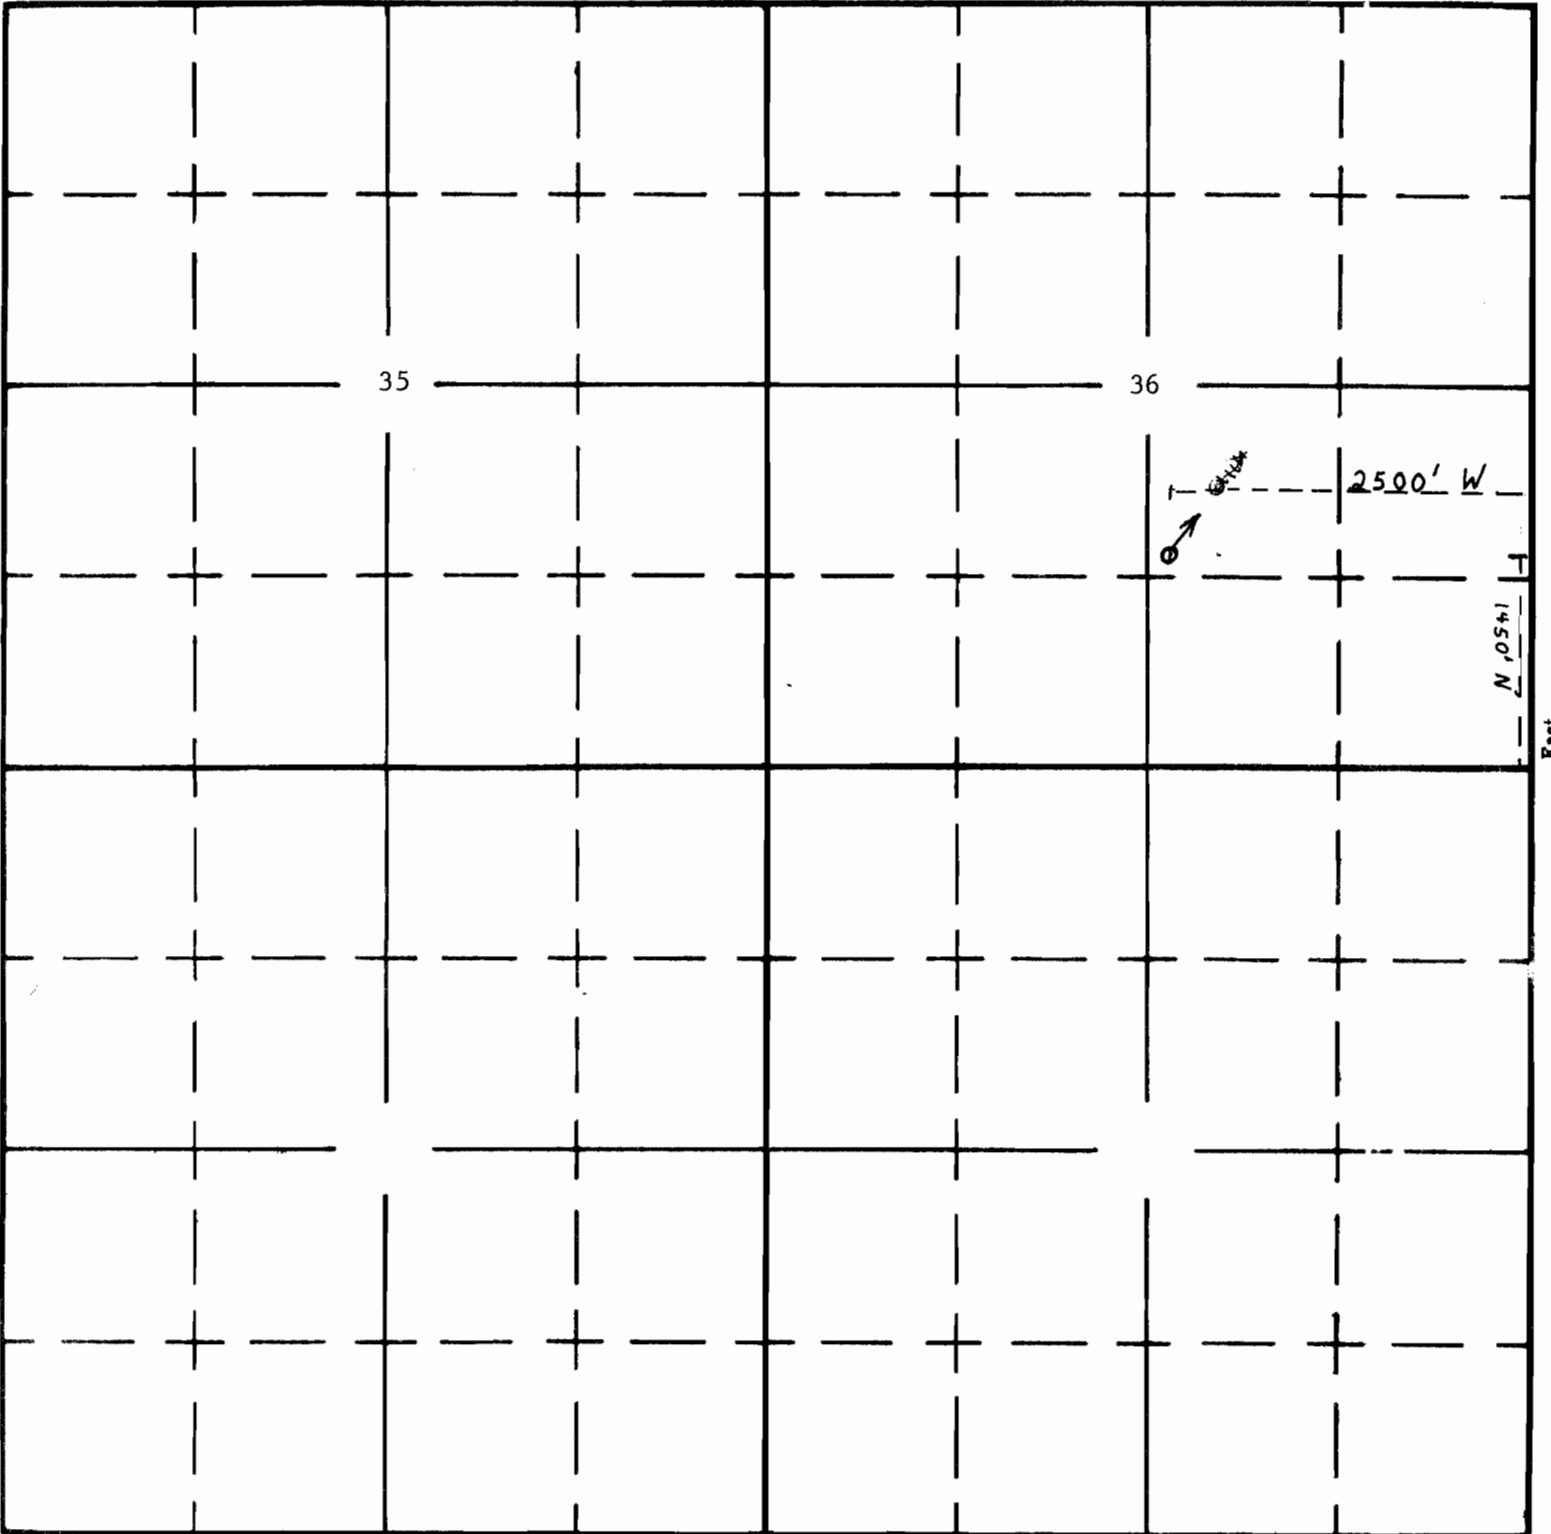

South

APPLICATION No. 38059
PERMIT No. 30202