

UNITED STATES
DEPARTMENT OF THE INTERIOR
BUREAU OF LAND MANAGEMENT


SECTION

17

Oregon State Water Filings

TOWNSHIP 14S, RANGE 45E, W. M.

North

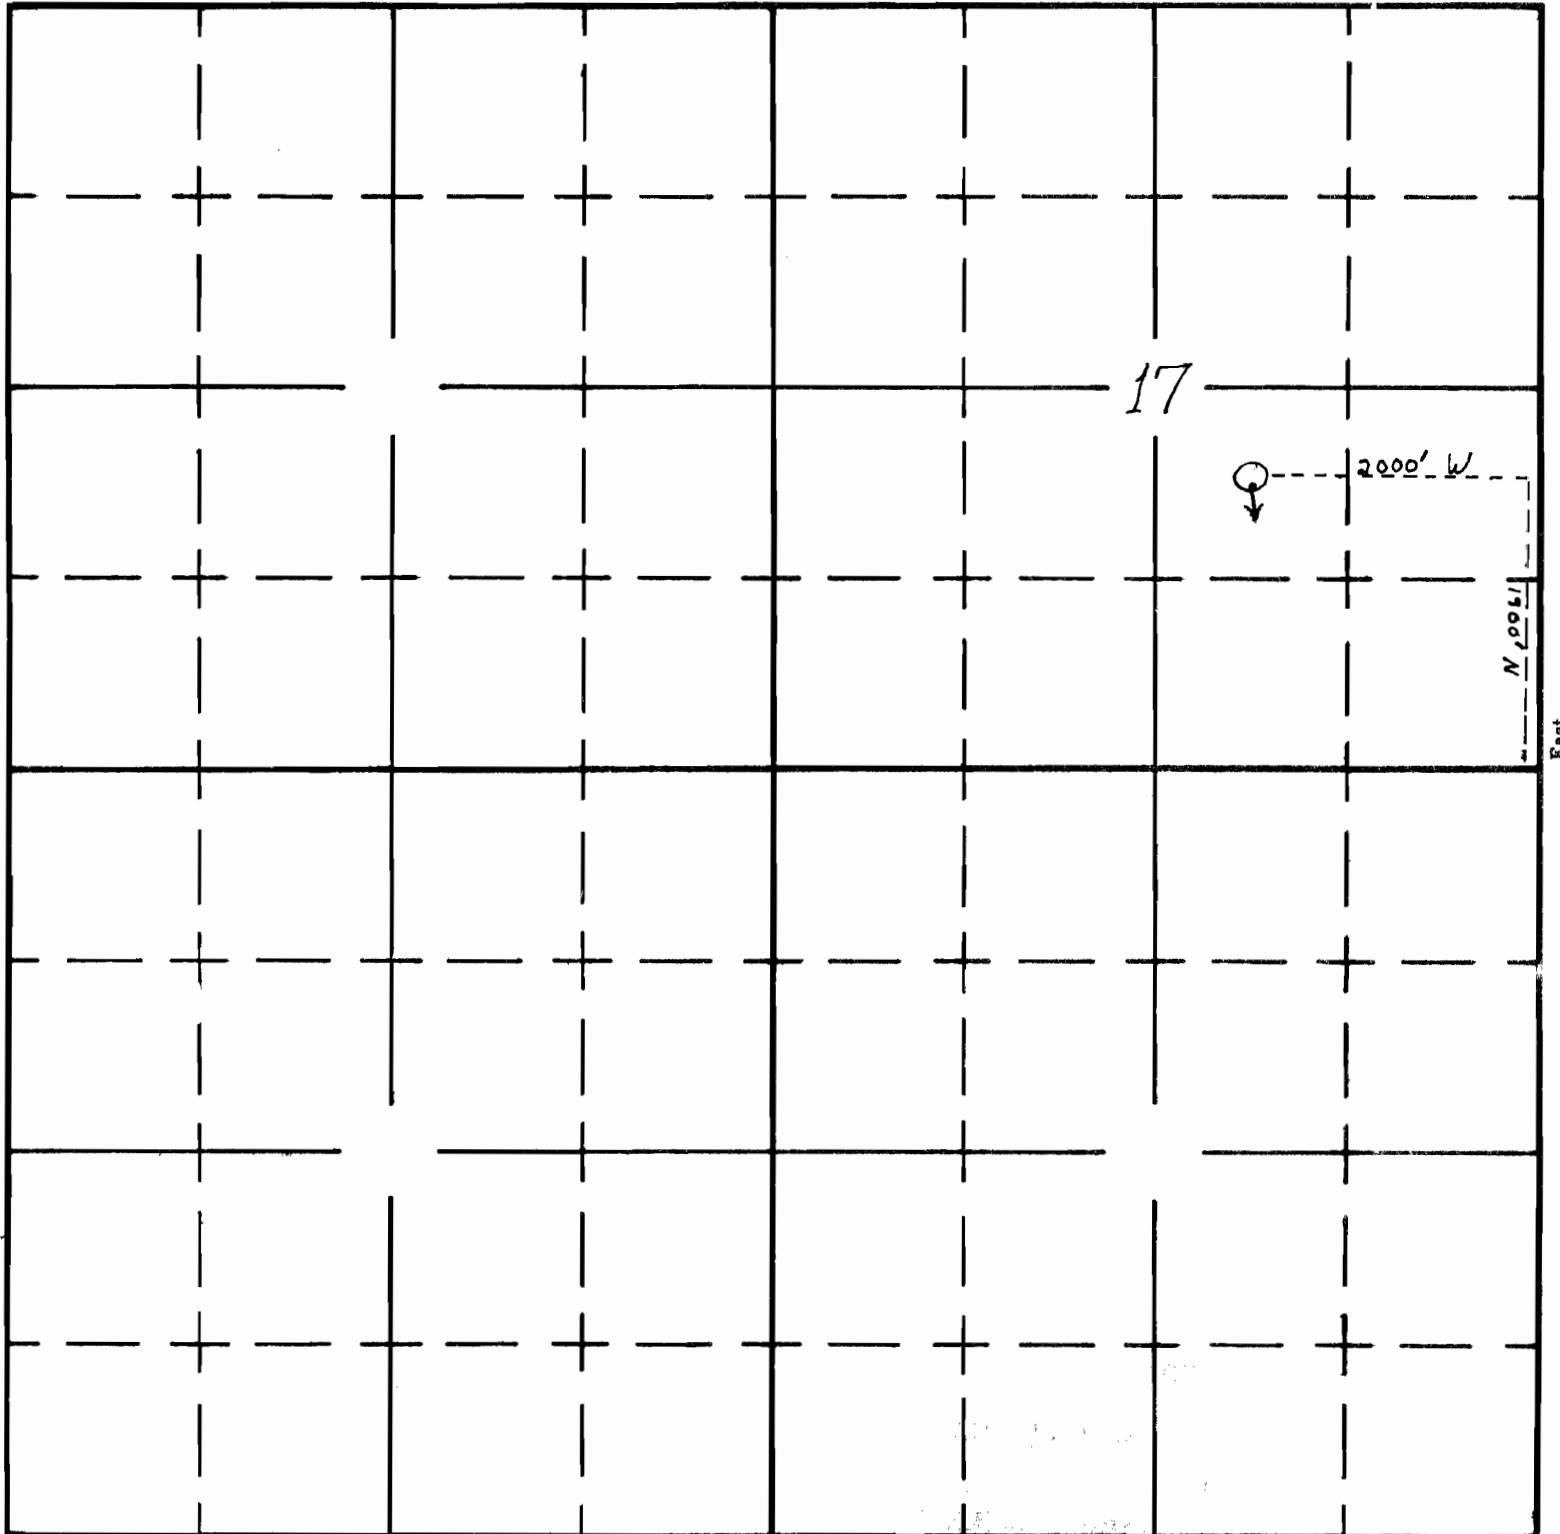

South

APPLICATION No. 37997

PERMIT No. 36196