



T.11 S.R.11 W.,.W.M.
Section 22
Lincoln County, Oregon

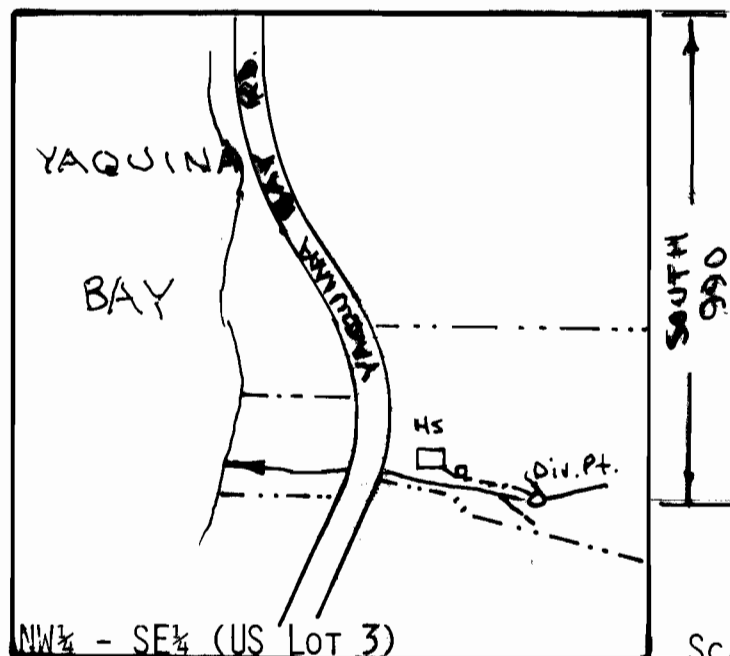

SCALE "1" = 400

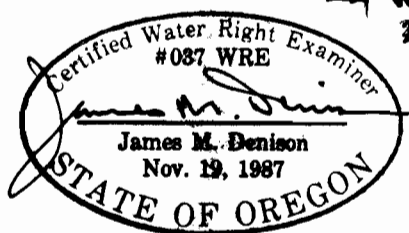

FINAL PROOF SURVEY
UNDER

RECEIVED
SEP 25 1987
SALEM, OREGON

APPLICATION #70504
IN THE NAME OF
DORIS ELLEN BAIRD

PERMIT # 51192

SURVEYED 08-23-91

BY J.M. Denison

This map prepared solely for the purpose of showing location of a water right, and is not intended for use to provide dimensions or location of property ownership lines.