

UNITED STATES  
DEPARTMENT OF THE INTERIOR  
BUREAU OF LAND MANAGEMENT

RECEIVED  
JUN 3 1981  
WATER RESOURCES DEPT  
SALEM, OREGON


SECTION

23

SE 1/4 SW 1/4


TOWNSHIP 38S., RANGE 6W., W. M.

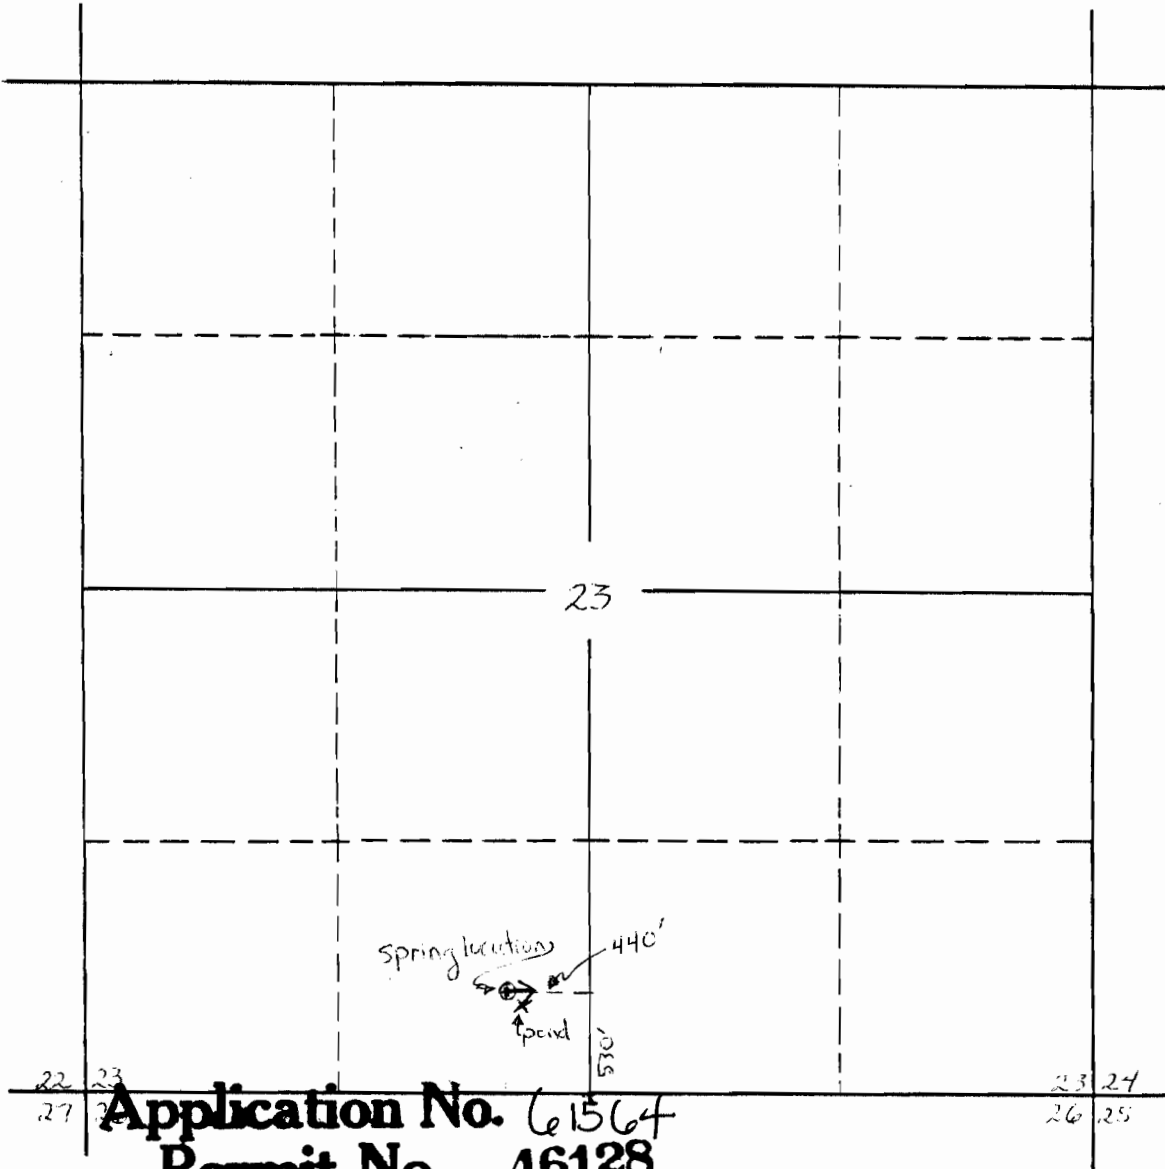

**Application No. 61564**  
**Permit No. 46128**

SCALE : 1" = 1000'

RECEIVED  
APR 21 1981  
WATER RESOURCES DEPT  
SALEM, OREGON