


TWP 27S, R2W, WM

SCALE 1" = 1320'

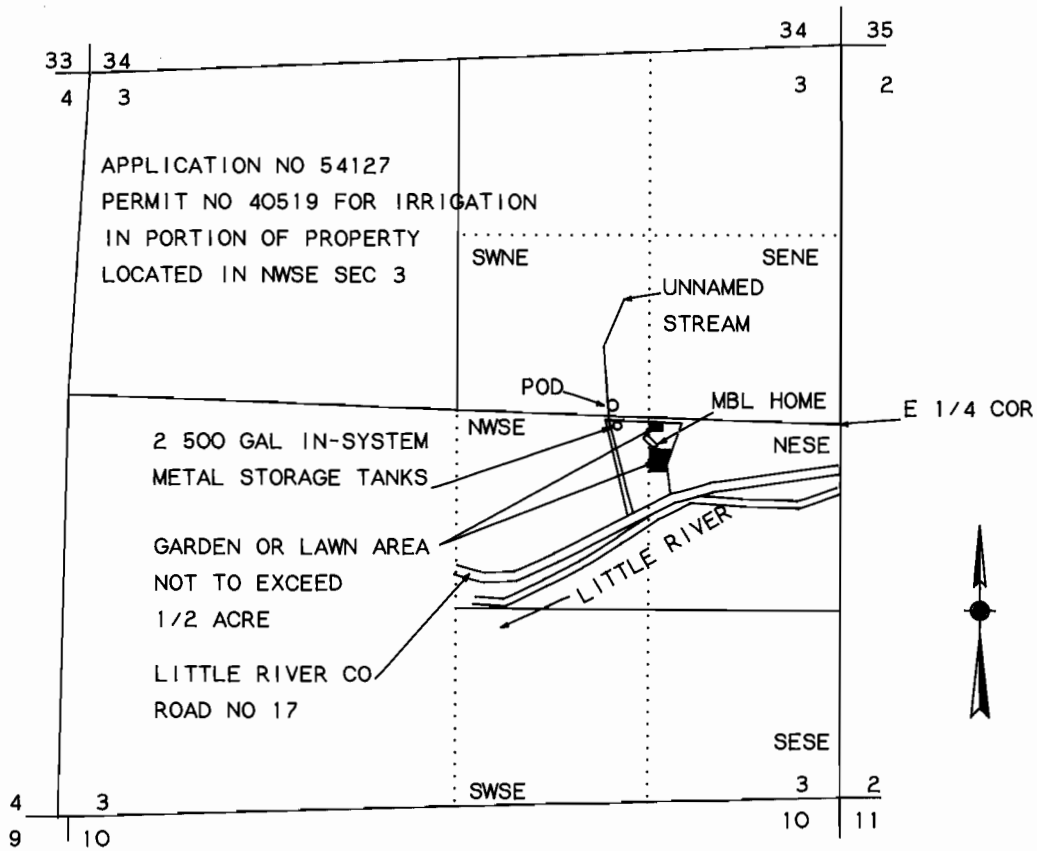

POD 1630 FT WEST AND 130 FT NORTH FROM E 1/4 COR SEC 3

FINAL PROOF SURVEY

UNDER

Application No. 70934 Permit No. 51168

IN NAME OF

JAN MORNARICH

Surveyed November 5, 1990 by M E Farr

