


UNITED STATES
DEPARTMENT OF THE INTERIOR
BUREAU OF LAND MANAGEMENT

SECTION

Oregon State Water Filings

TOWNSHIP 22S, RANGE 39E, W. M.

Willhouse Basin Res North

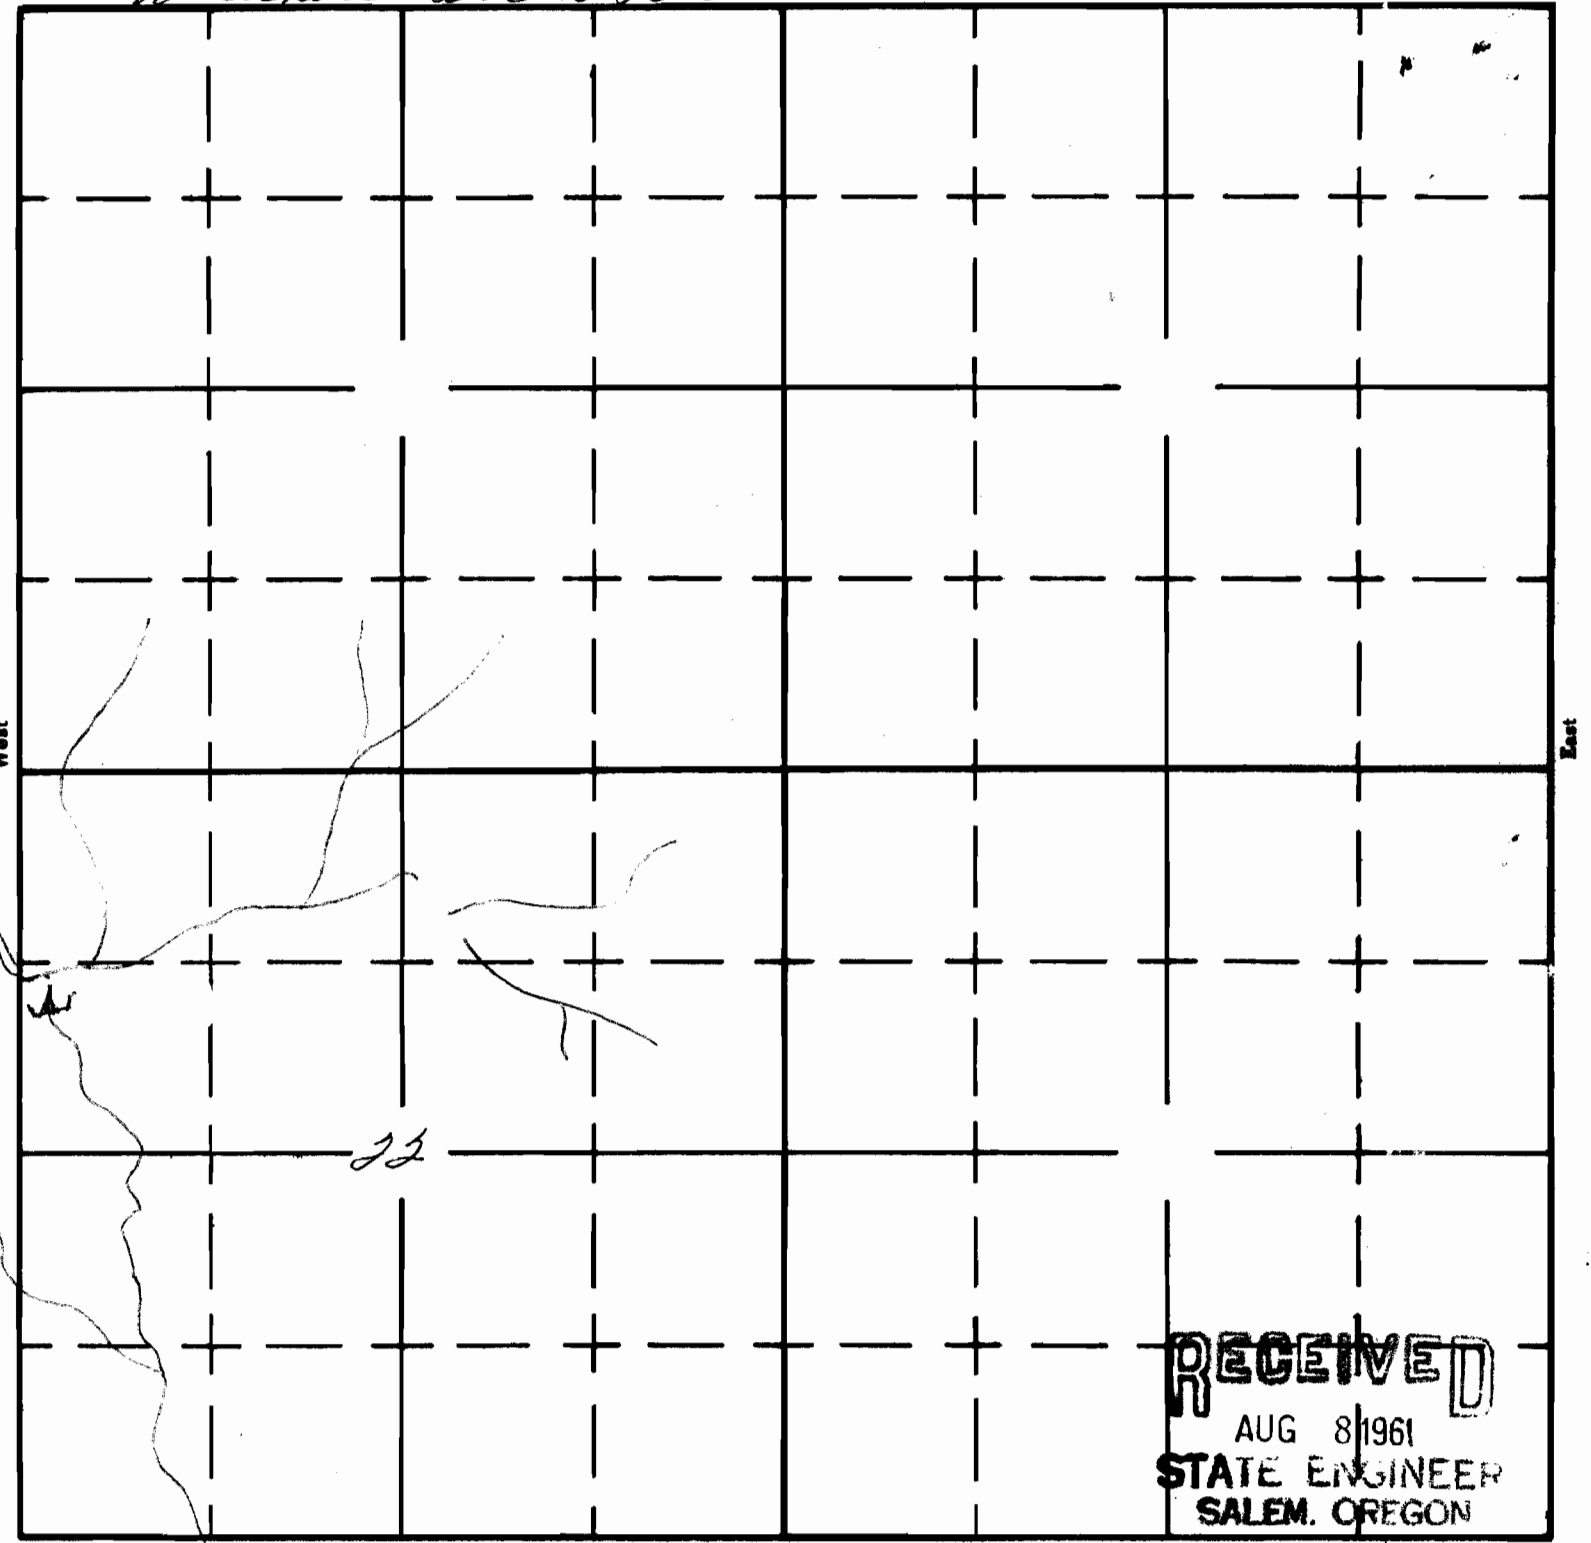

RECEIVED
AUG 8 1961
STATE ENGINEER
SALEM, OREGON

South