

UNITED STATES
DEPARTMENT OF THE INTERIOR
BUREAU OF LAND MANAGEMENT


SECTION

29

Oregon State Water Filings

TOWNSHIP 30s, RANGE 33e, W. M.

North

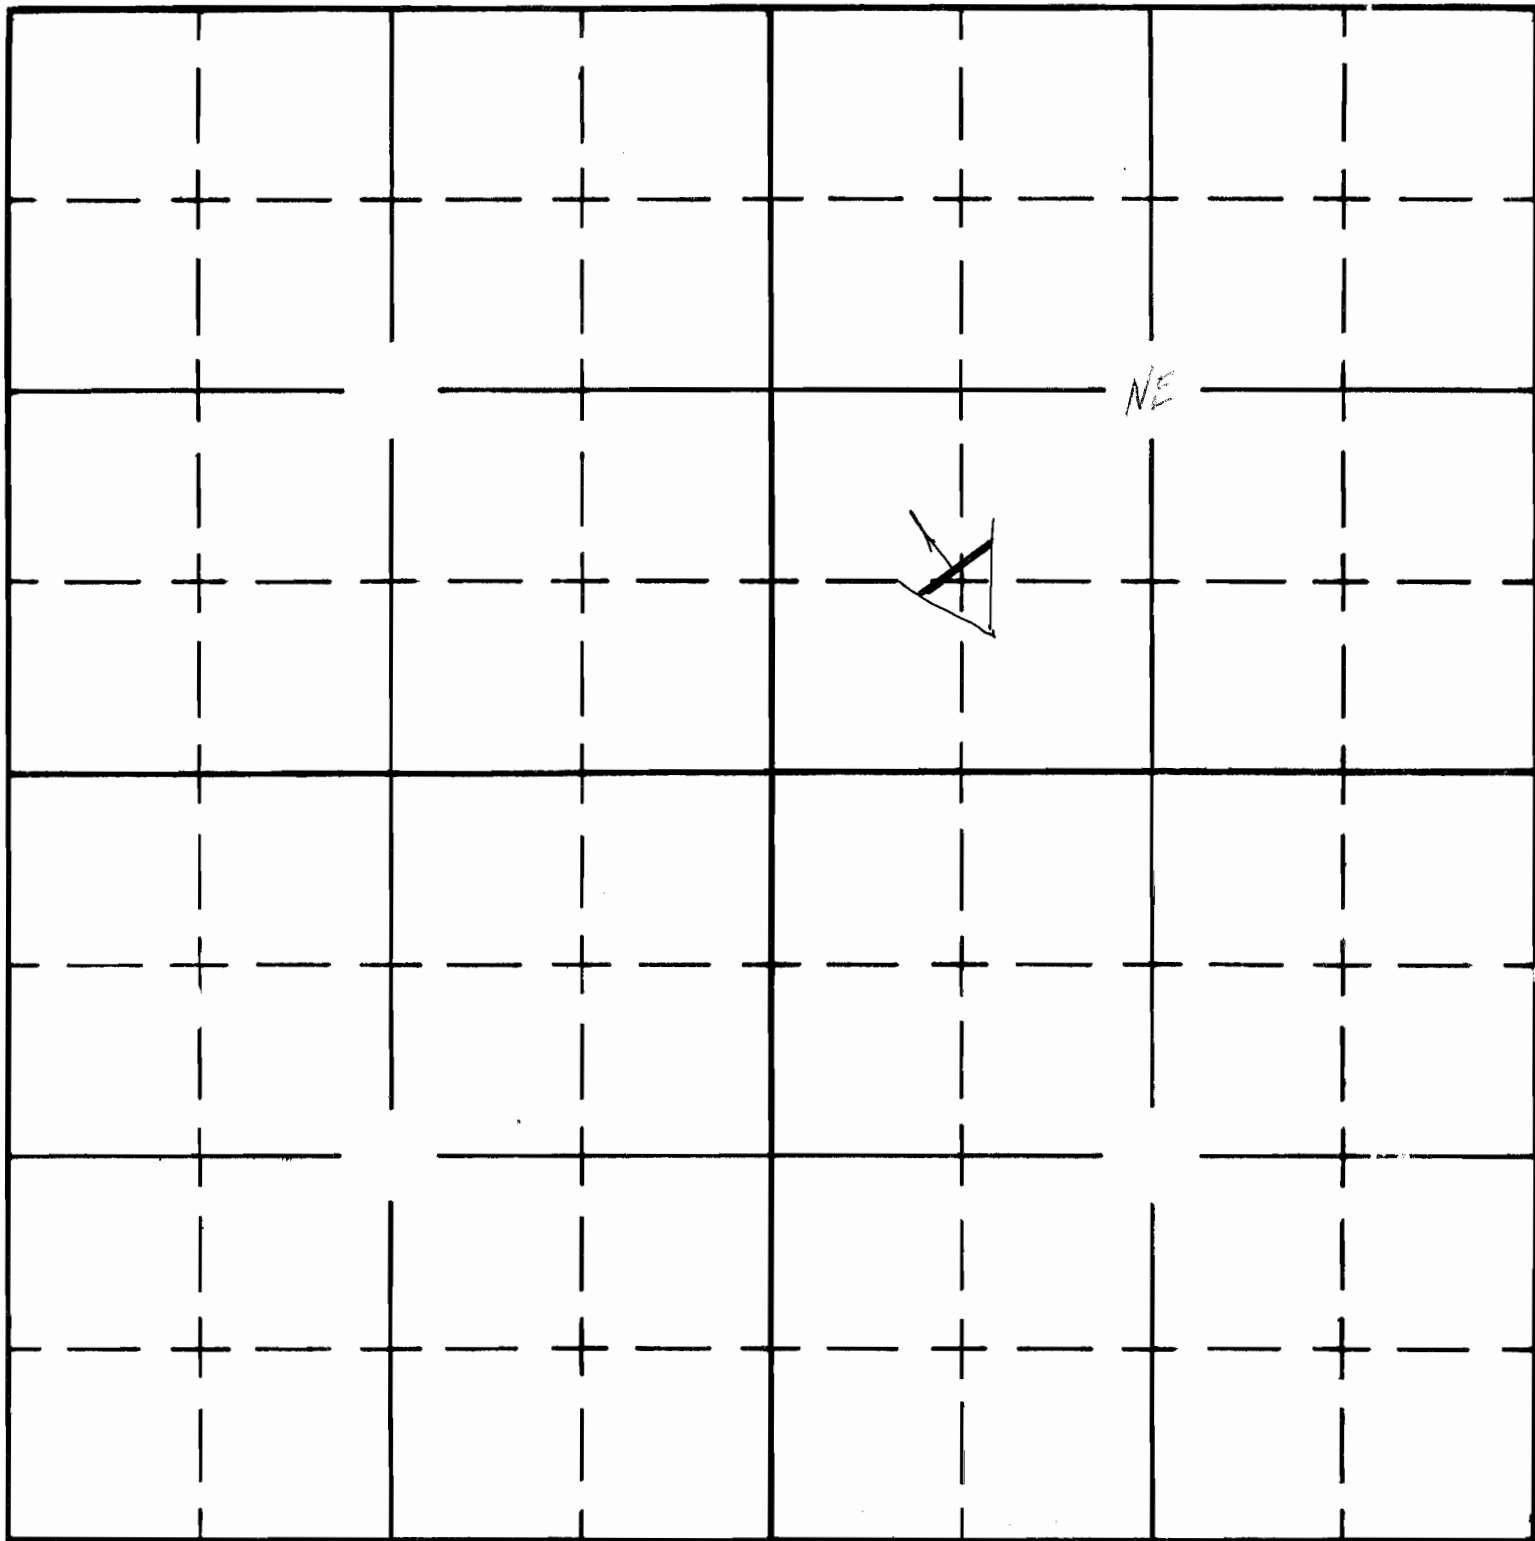

South

APPLICATION No. R-38307
PERMIT No. R-3259