G-10247
66766

T. 6N., R. 34E., W.M.

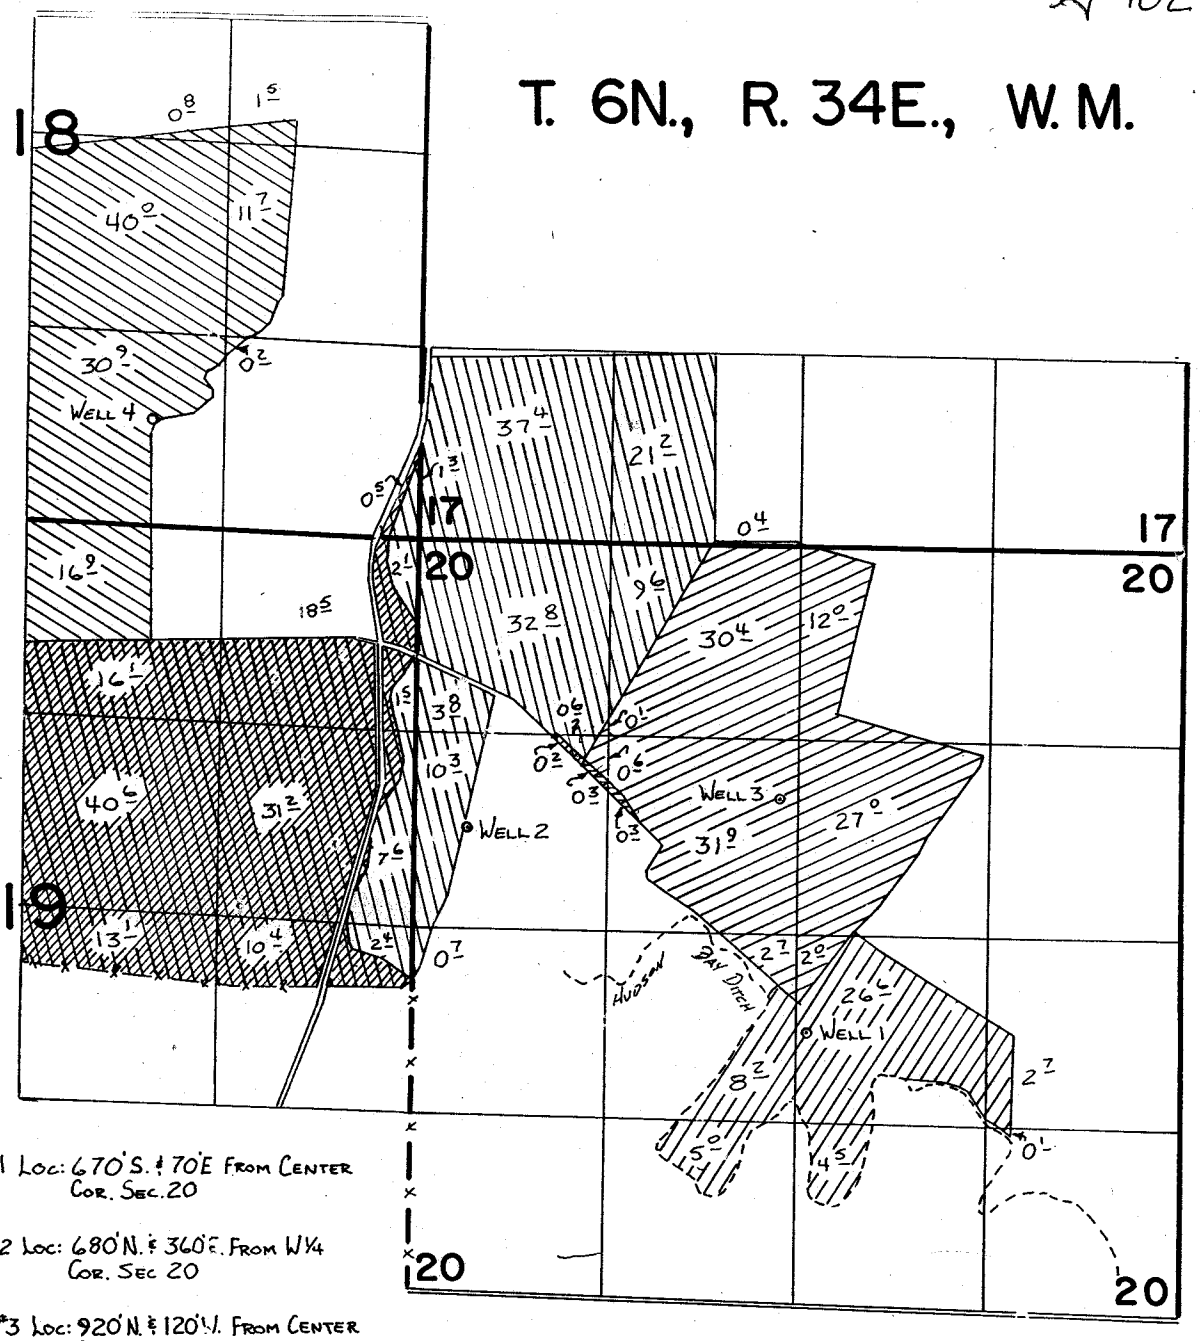

Suppl Prim

- Well #1 Loc: 670'S. & 70'E From Center Cor. Sec. 20
- Well #2 Loc: 680'N. & 360'E. From W¼ Cor. Sec 20
- Well #3 Loc: 920'N. & 120'W. From Center Cor. Sec 20
- Well #4 Loc: 730'N. & 850'E From S¼ Cor. Sec. 18

FINAL PROOF SURVEY

UNDER

Application No. G:17 Permit No. G:10247

IN NAME OF

WHITE BROS. CONSTRUCTION CO. INC.

Surveyed 9:10 19 87, by V.L. Church

SCALE 1" = 1320'

NE-SMM-19
41059-378-251R

VLC