


T.28S., R.15 & 16E., W.M.

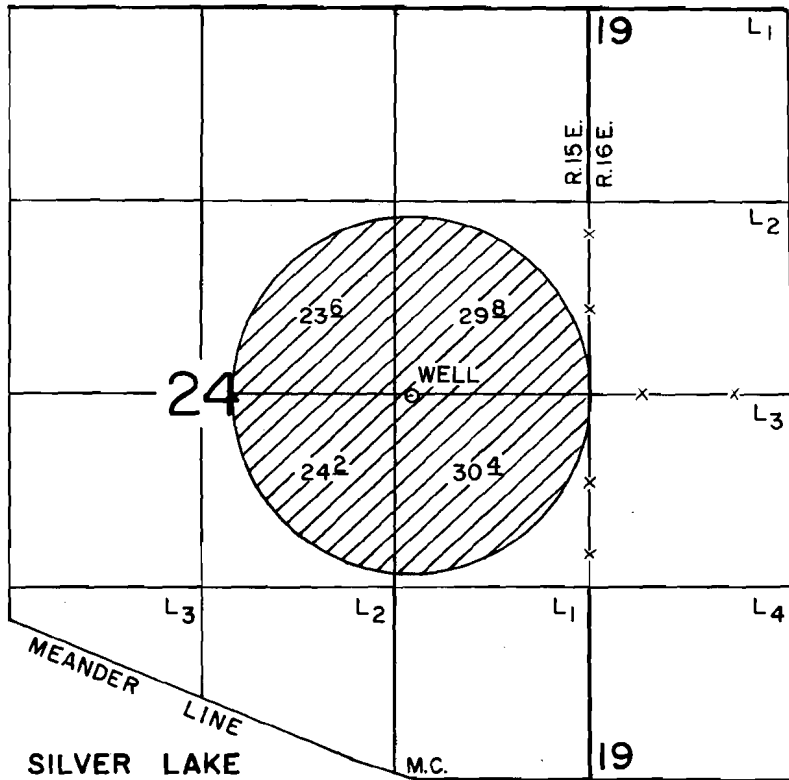

WELL LOC.: 10'S. & 1220'W. FROM THE E. 1/4 CORNER SEC. 24

SCALE: 1" = 1320'

FINAL PROOF SURVEY UNDER

Application No. G-8231. Permit No. G-7846....
IN NAME OF

.....EVAN CARLON.....

Surveyed SEPT. 15, 1985, by T. WARREN.....