



G-9173
66770

T.24S., R.18E., W.M.

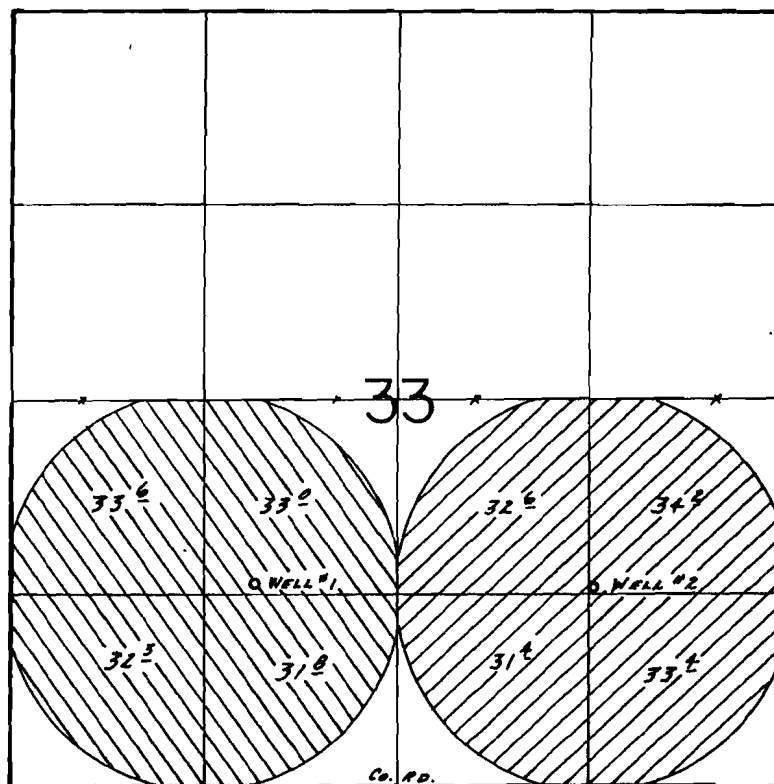

WELLS LOC.: #1-1400' N. & 1660' E., #2-1370' N. & 3990' E.,
BOTH FROM SW COR. SEC. 33.

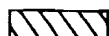

Permit G-7921



Permit G-9173

SCALE: 1"=1320'

FINAL PROOF SURVEY UNDER

G-8566 G-7921
Application No. G-10108 Permit No. G-9173.....
IN NAME OF

ADRIAN L. WILCOX

Surveyed Sept. 1, 1988, by B.W. BISHOP.....