


T. 33S., R. 31E., W.M.

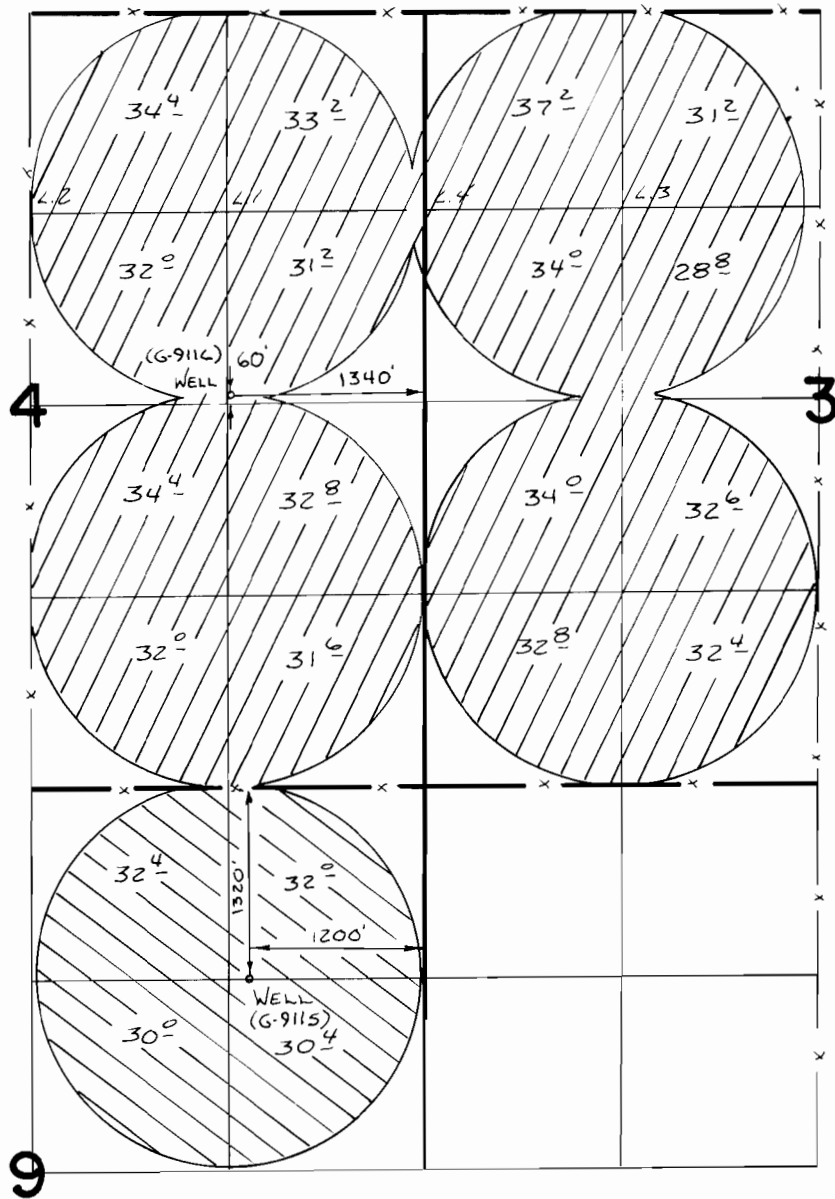

SCALE 1" = 1320'



G-9115



G-9116

FINAL PROOF SURVEY

UNDER

G-9934

G-9116

Application No. **G-9933** Permit No. **G-9115**

IN NAME OF

Surveyed 9-1-1988 by V.L. Church