


T. 33S., R. 31E., W.M.

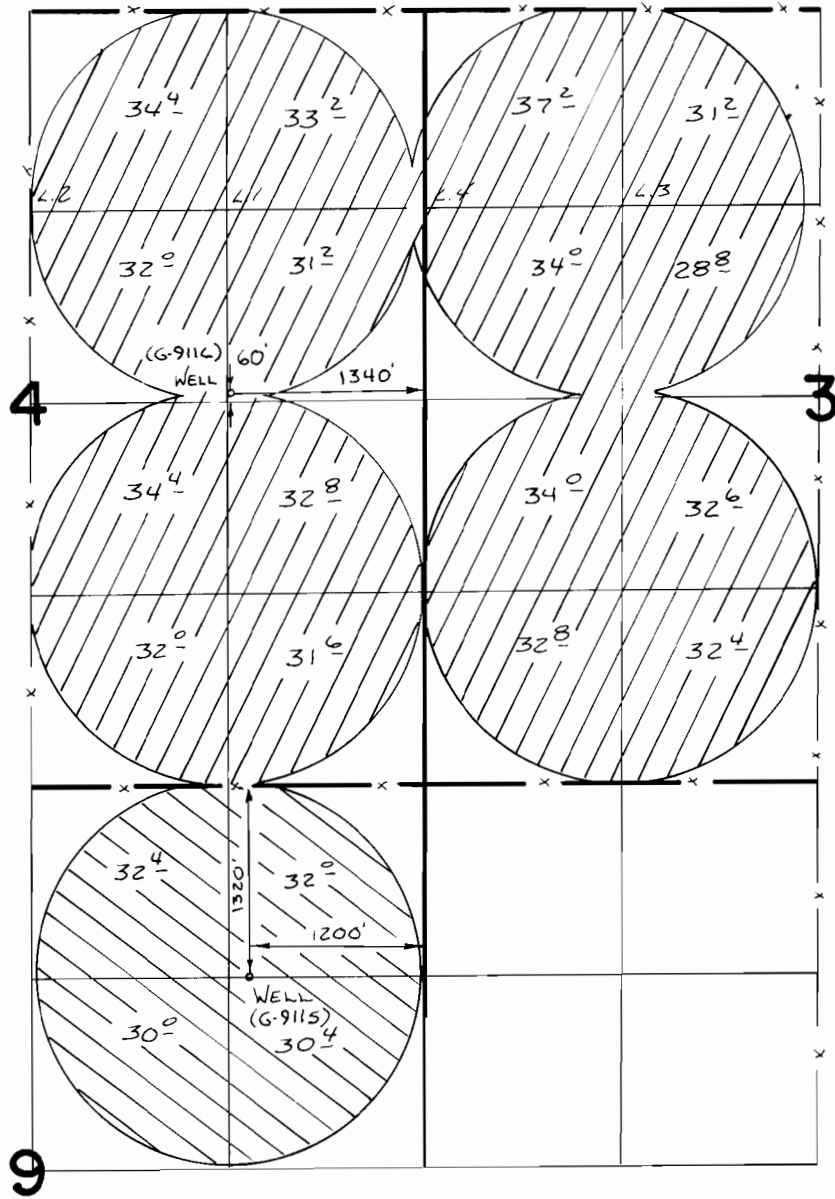

SCALE 1" = 1320'



G-9115



G-9116

FINAL PROOF SURVEY
UNDER

G-9934 **G-9116**
Application No. **G-9933** Permit No. **G-9115**
IN NAME OF

Surveyed 9-1-1988 by V.L. Church