



# T. 16S., R. 43E., W.M.

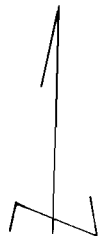

SCALE 1" = 1320'

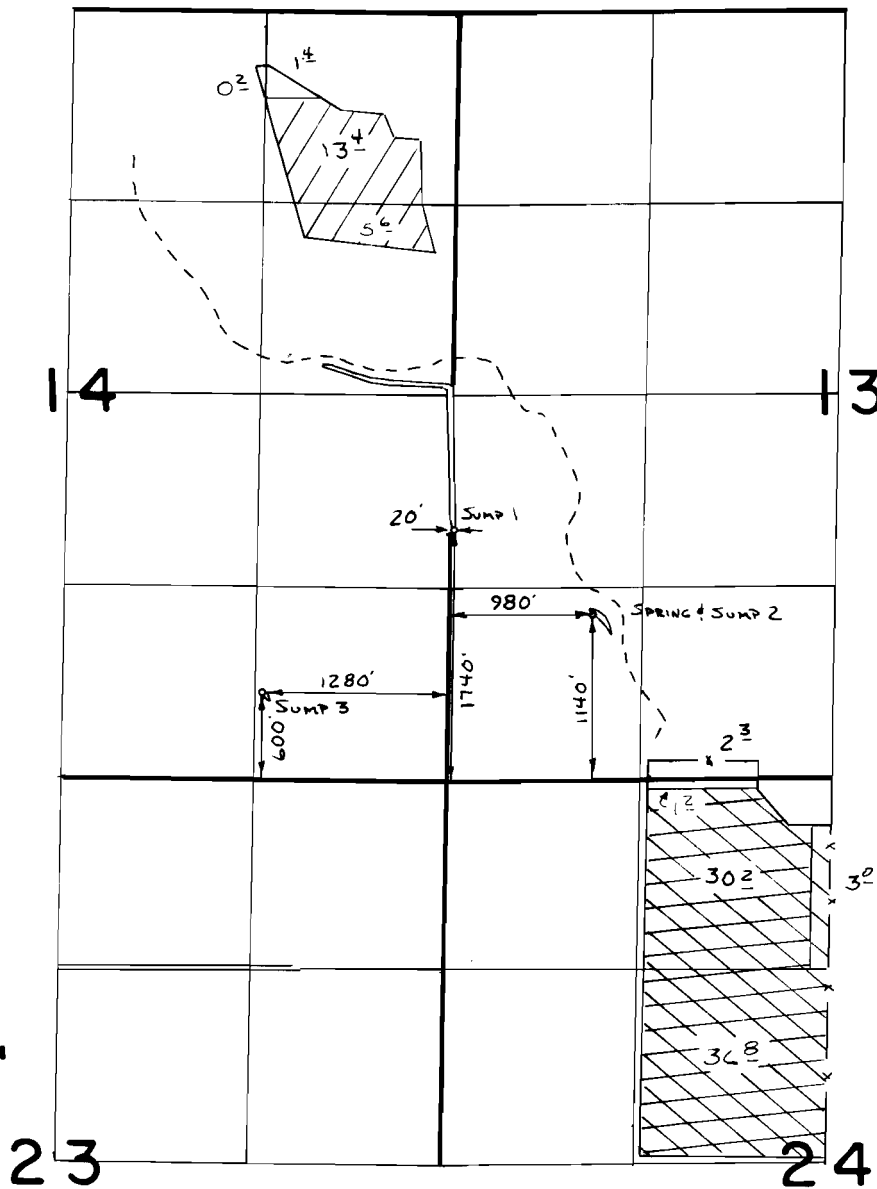

G-9928



46397



G-9739

## FINAL PROOF SURVEY

UNDER

G-10631

G-9739

60974

46397

Application No. **G-10799** Permit No. **G-9928**...

IN NAME OF

..... **HIRO** ..... **KAMO** .....

Surveyed *10-10* 19*88*, by *V.L. Church*.....