


# T. 28 S., R. 14 W., W. M.

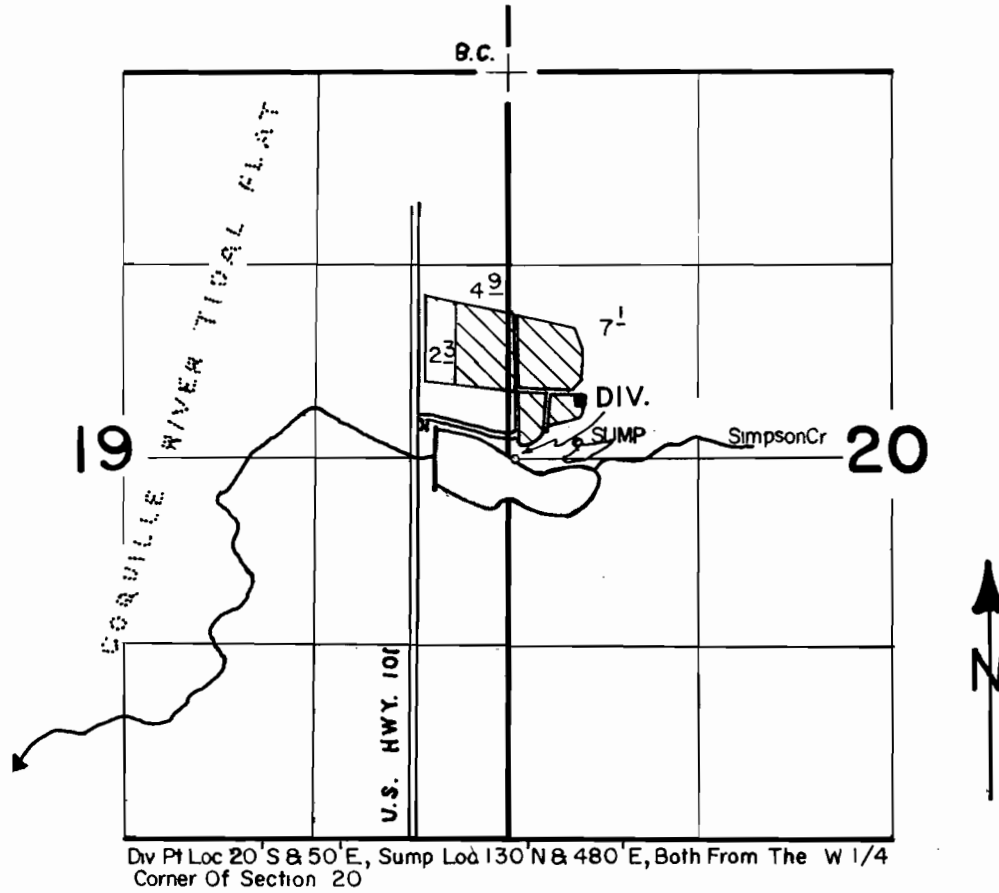

SCALE 4" = 1 MILE

## FINAL PROOF SURVEY UNDER

G-10660                      G-9986  
 Application No. 60812      Permit No. 47352  
 IN NAME OF

H. R. AMOS

Surveyed JUNE 11 1986, by J. M. SCHMORDE  
 SEPT 20 1989              B. S. JAMES