




T. 19 S., R. 44 E., W.M.

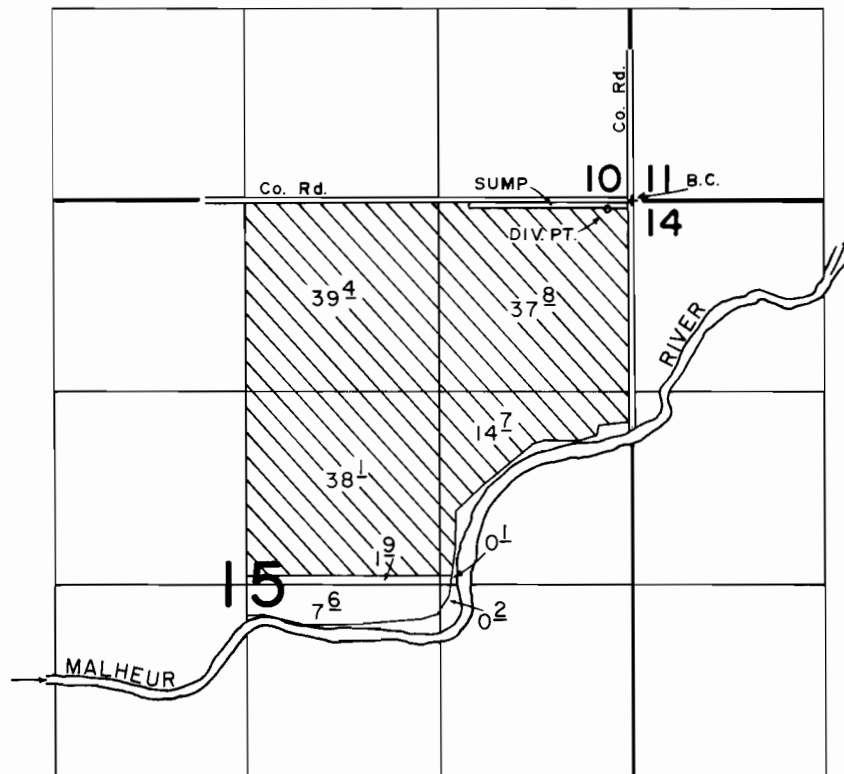

DIV. PT. LOC.: 50' S. & 170' W. FROM NE CORNER SECTION 15

SCALE: 1" = 1320'

FINAL PROOF SURVEY UNDER

Application No. G-10834 Permit No. G-9956...
IN NAME OF

STEPHEN S. RECLA

Surveyed APRIL 29 1986, by L. M. TOLL