


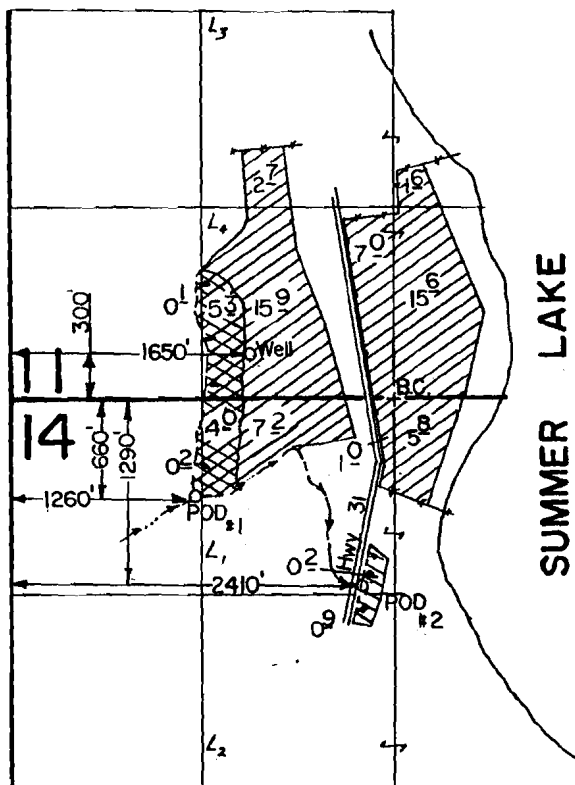


FINAL PROOF SURVEY

UNDER

Application No. G-10974. Permit No. G-10152.....
IN NAME OF

DARRELL SEVEN

Surveyed Oct...14.. 1985, by L. Warren.....

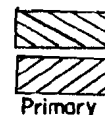

Primary



Supplemental