


T.32 S., R.16 E., W.M.

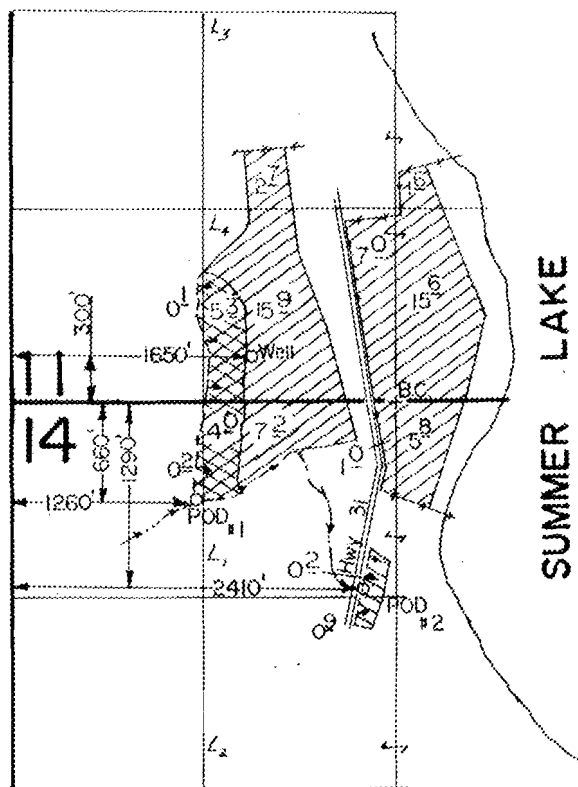

Scale : 1" = 1320'

FINAL PROOF SURVEY UNDER

65504

47978

Application No. G-10974. Permit No. G-10152.....


IN NAME OF

DARRELL SEVEN

Surveyed Oct. 14, 1985, by L. Warren.....



Primary

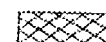

Supplemental