

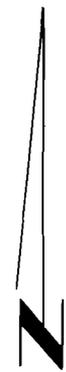


T. 1 S. R. 44 E. W.M.

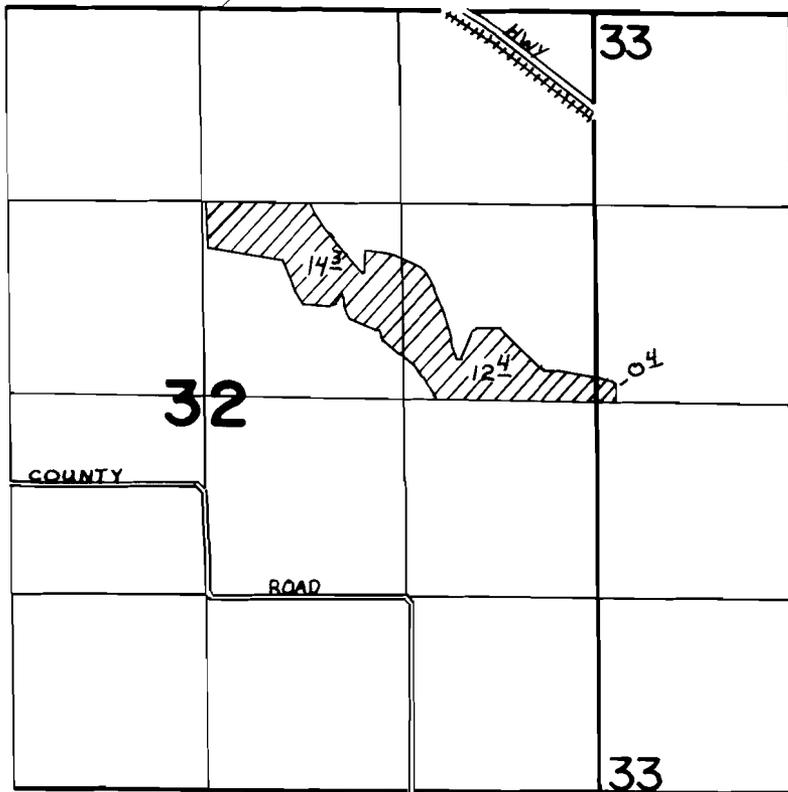

SCALE: 1"=1320'

T. 2 S. R. 44 E. W.M.

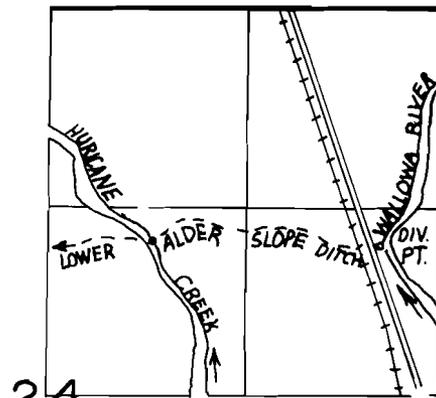

24

DIV. PT. LOCATED 390' W. AND 1030' N. FROM E 1/4 COR. SEC. 24

FINAL PROOF SURVEY
UNDER

Application No. 54382. Permit No. 40756.....
IN NAME OF

.....**LARRY MOORE**.....

Surveyed ..Aug. 6..... 1924., by ..V.L. CHURCH.....