


T. 7S., R. 45E., W.M.

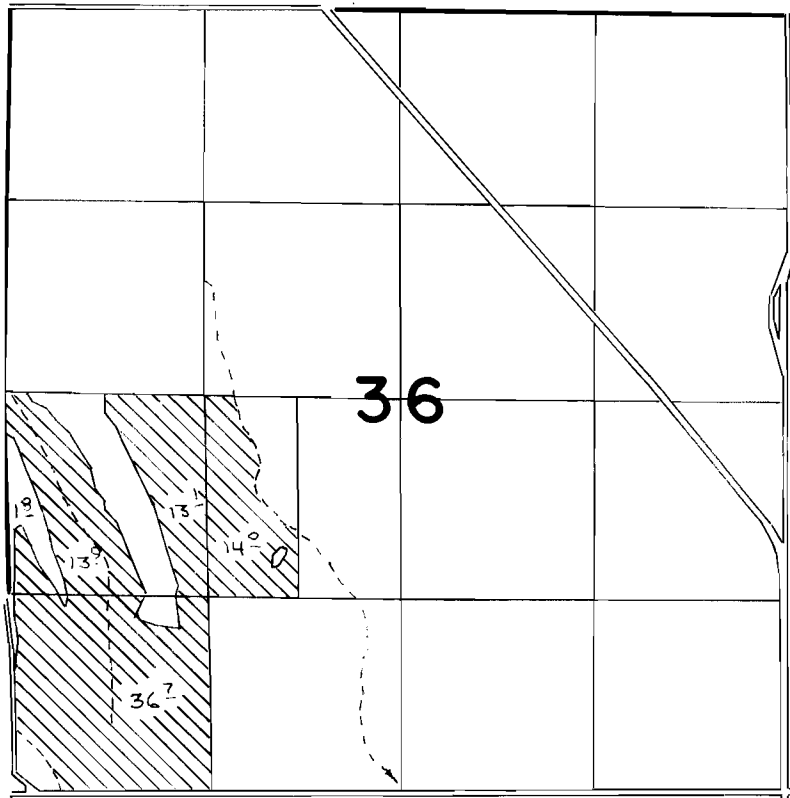

POSEY DITCH LOC. 160'S & 200' W. FROM NE COR. SECTION 22
T. 7S., R. 45E.

FINAL PROOF SURVEY
UNDER

Application No. **56293** Permit No. **43532**...
IN NAME OF

.....**LOUISE W. SLY**.....

Surveyed *8-1*..... 19*84*., by *V.L. Church*.....



SCALE: 1" = 1320'