


T.29S. R.5W. W.M.

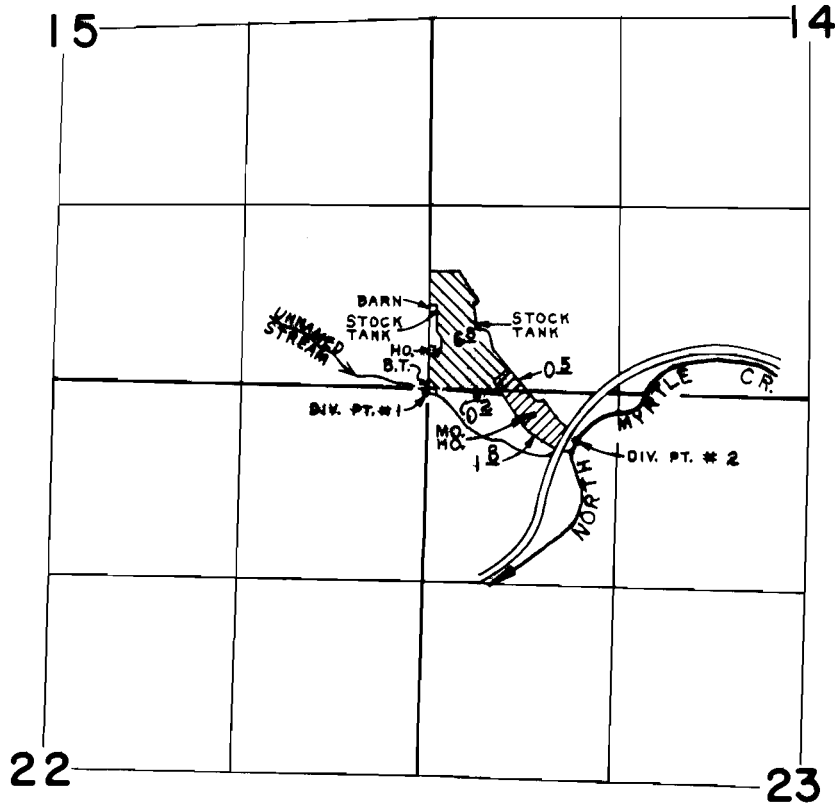

DIV. PT. #1 LOCATED 25'S. & 15'W. FROM COR. SEC. 14,15,22,23
 DIV. PT. #2 LOCATED 365'S. & 1,035'E. FROM COR. SEC. 14,15,22,23



42448 44437

SCALE: 4"=1mile

FINAL PROOF SURVEY

UNDER

Application No. 56535 42448
 58864 Permit No. 44437

IN NAME OF

CHARLES W. & GAIL M. JOHNSON

Surveyed DEC. 27, 1983, by D. CLARK