


T.14S., R.14E., W.M.

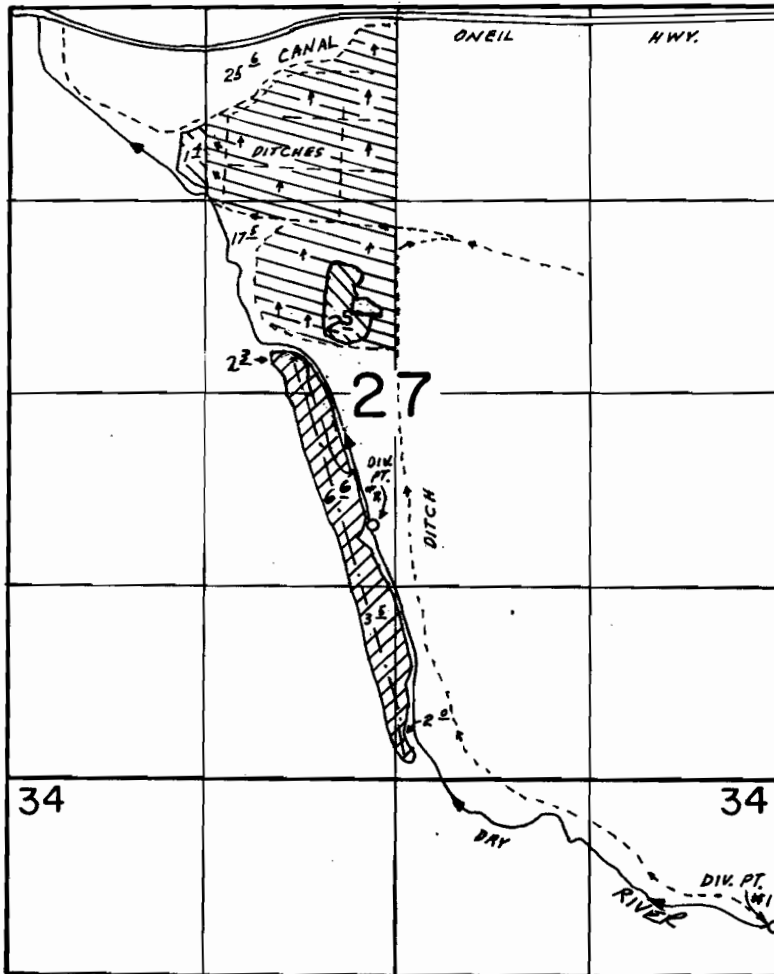


DIV. PT. #1 LOC. 1000' S. & 10' W. OF THE NE COR. SEC. 34
 DIV. PT. #2 LOC. 900' S. & 175' W. OF THE C 1/4 COR. SEC. 27

SCALE: 1"=1320'

FINAL PROOF SURVEY
 UNDER

Application No. 56353. Permit No. 42708
 56648. Permit No. 42709.....
 IN NAME OF

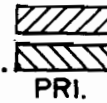

C-66786
 C-66789

JAMES & EMILY BONA VIA

Surveyed JUN. 1 1988, by B. BISHOP

Rec'd 10-18-91 WDP#4