


# T. 12 S., R. 5 W., W. M.

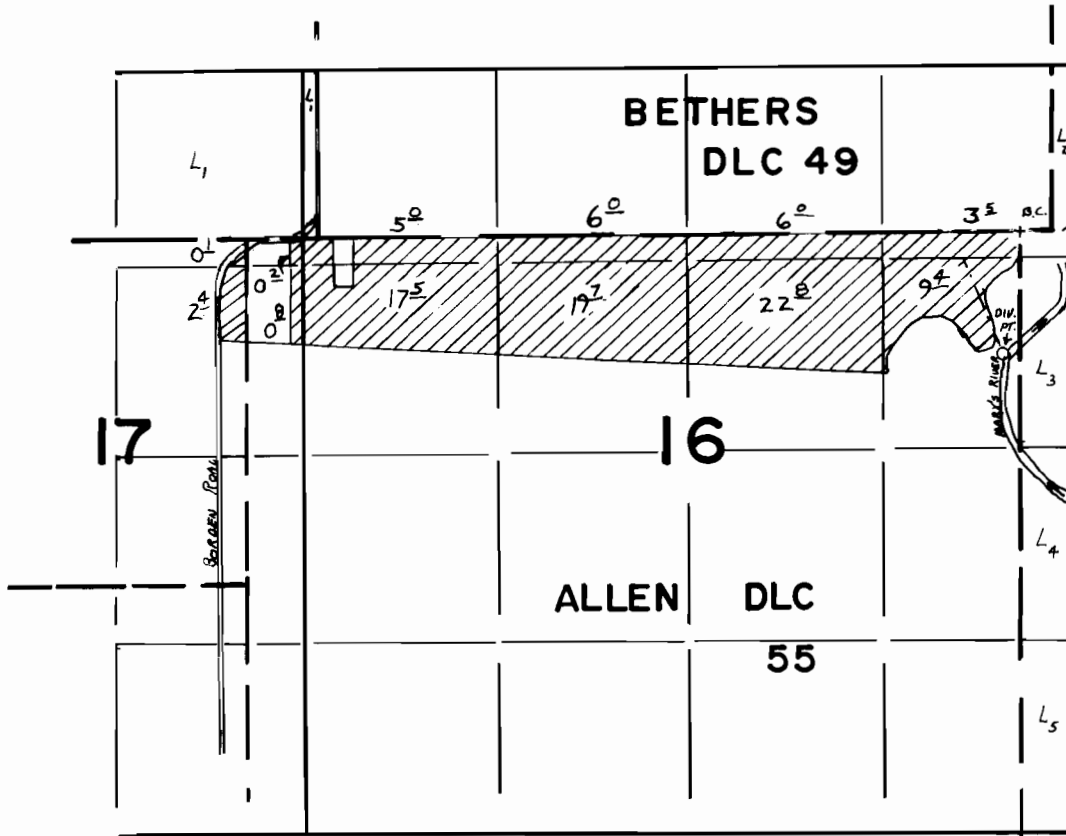

Div. Pt. Loc.: 850' S. & 100' W. from the NE Cor. ALLEN DLC 55

## FINAL PROOF SURVEY

UNDER

Application No. 58621... Permit No. 44195.....  
IN NAME OF

.....GRANT..... CORNELIUS.....

Surveyed JULY 7, 1983, by L. TOLL.....