


T. 16S., R. 43E., W.M.

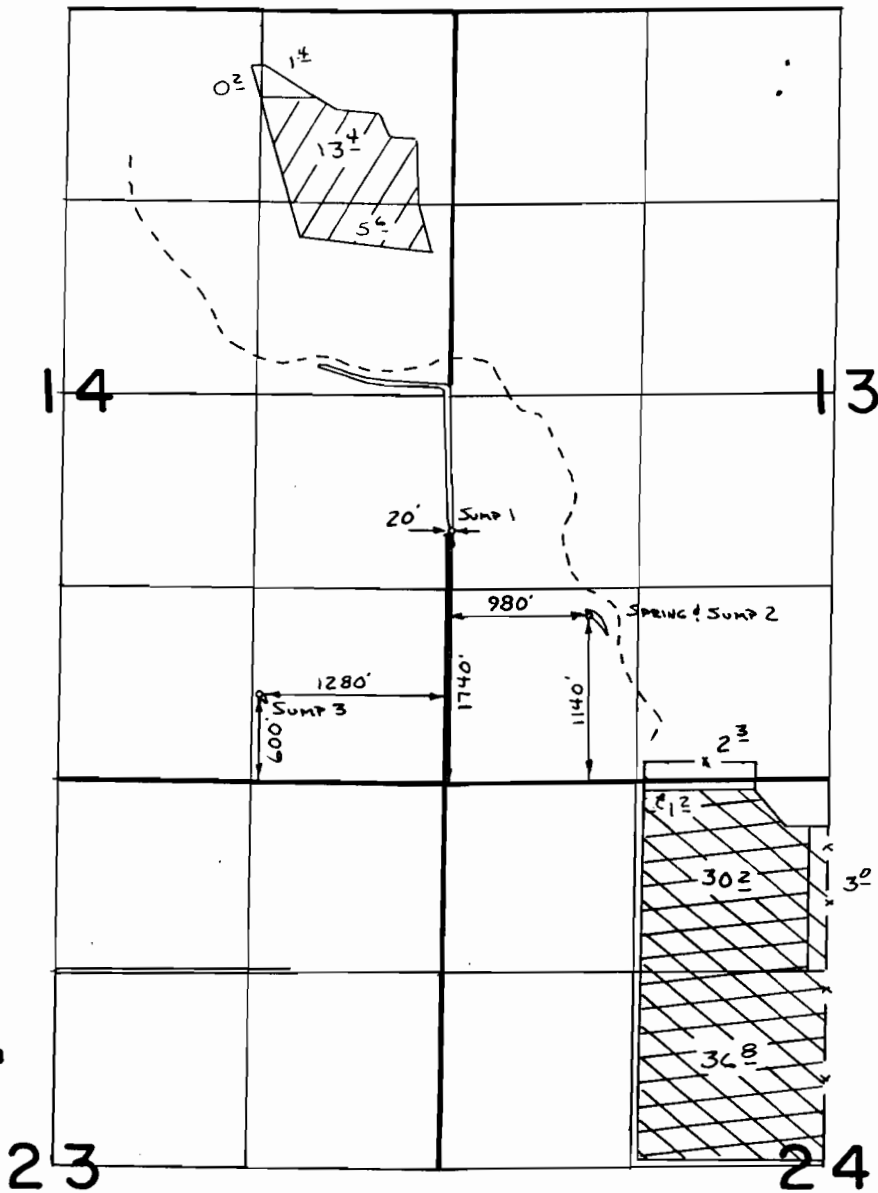

SCALE 1" = 1320'



G-9928



46397



G-9739

FINAL PROOF SURVEY

UNDER

G-10631

G-9739

60974

46397

Application No. ~~G-10799~~ Permit No. ~~G-9928~~

IN NAME OF

.....HIRO.....KAMO.....

Surveyed 10-10 1988, by V.L. Church