



# T. 39 S. & 40 S., R. 3 W., W.M.

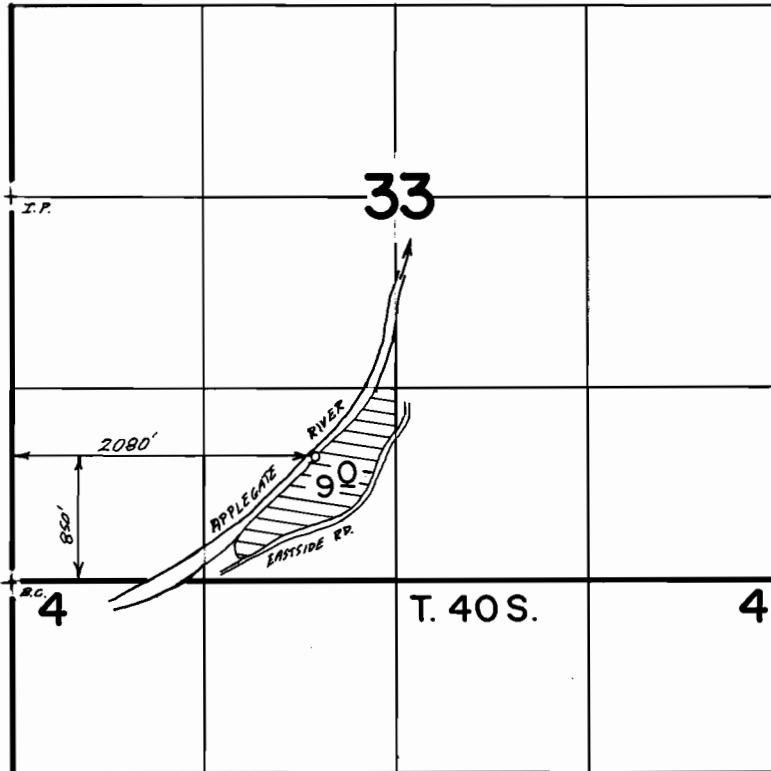

Scale 1"=1320'

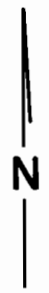

## FINAL PROOF SURVEY UNDER

61326                      45607  
 Application No. 68297. Permit No. 49401.....  
 IN NAME OF

SHAUNA M. MAGNUSEN.....

Surveyed Nov. 10, 1987, by B.S. JAMES.....