


T. 39 S. & 40 S., R. 3 W., W. M.

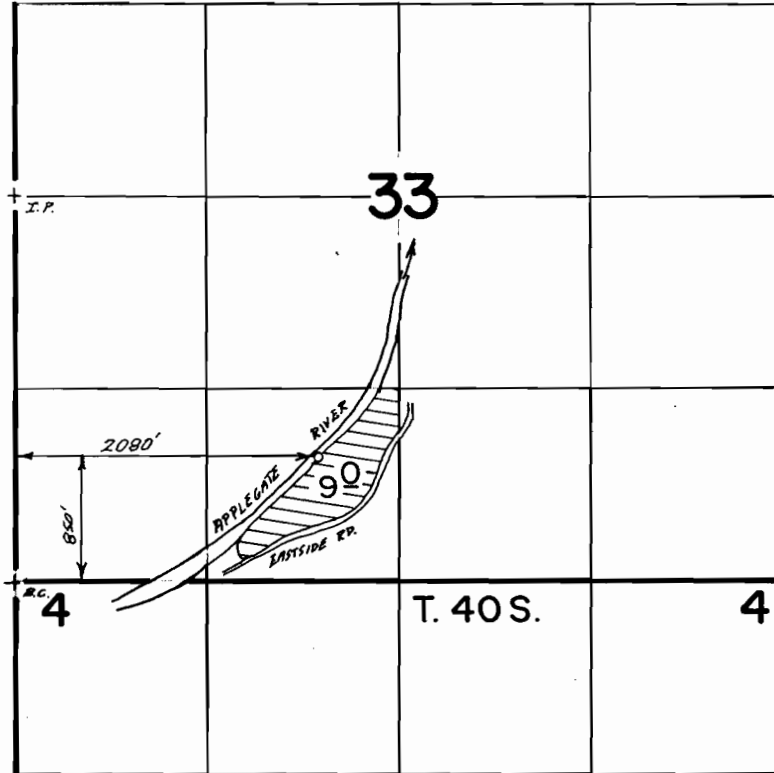

Scale 1"=1320'

FINAL PROOF SURVEY
UNDER

61326 45607
Application No. 68297. Permit No. 49401.....
IN NAME OF

...SHAUNA M. MAGNUSEN.....

Surveyed Nov. 10, 1987, by B.S. JAMES.....