
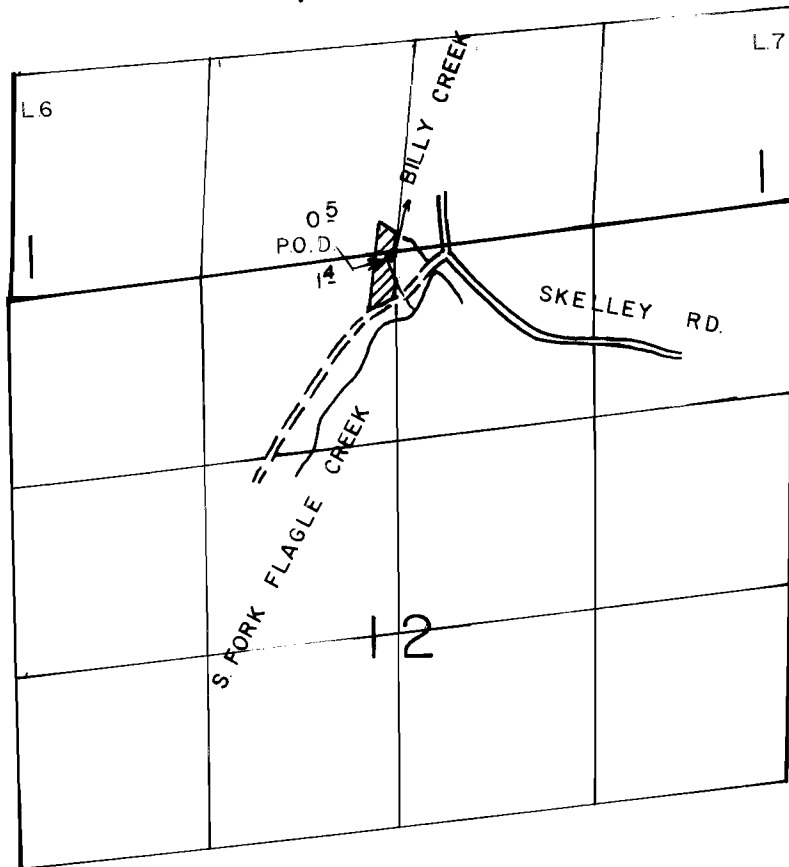


T. 23 S., R. 6 W., W.M.

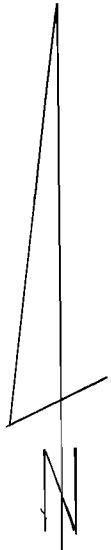

1" = 1320'

DIVERSION LOCATED 10' S. & 40' W. FROM N. 1/4 CORNER SEC. 12

### FINAL PROOF SURVEY UNDER

Application No. 63389 Permit No. 46753

IN NAME OF

BOB TURNER

Surveyed SEPT. 13, 1990, by B. S. JAMES

6-14-91 DSM  
41019-278-154 L