
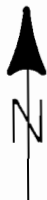


T. 28 S., R. 5 W., W. M.

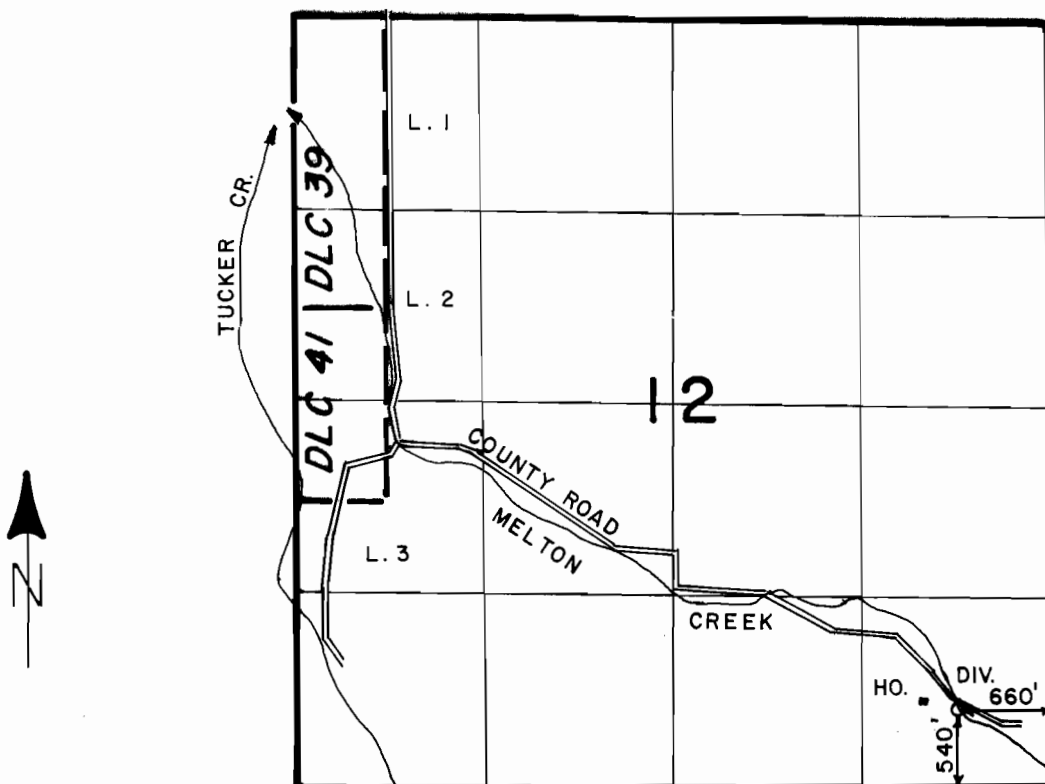

SCALE: 4" = 1 MILE

**FINAL PROOF SURVEY**  
UNDER

Application No. 68537... Permit No. 49475.....  
IN NAME OF

**BILLY RAY & EDNA MARLYAN MCCRAW**

Surveyed JAN. 8... 1988., by J. M. SCHMORDE