


T. 28 S., R. 5 W., W. M.

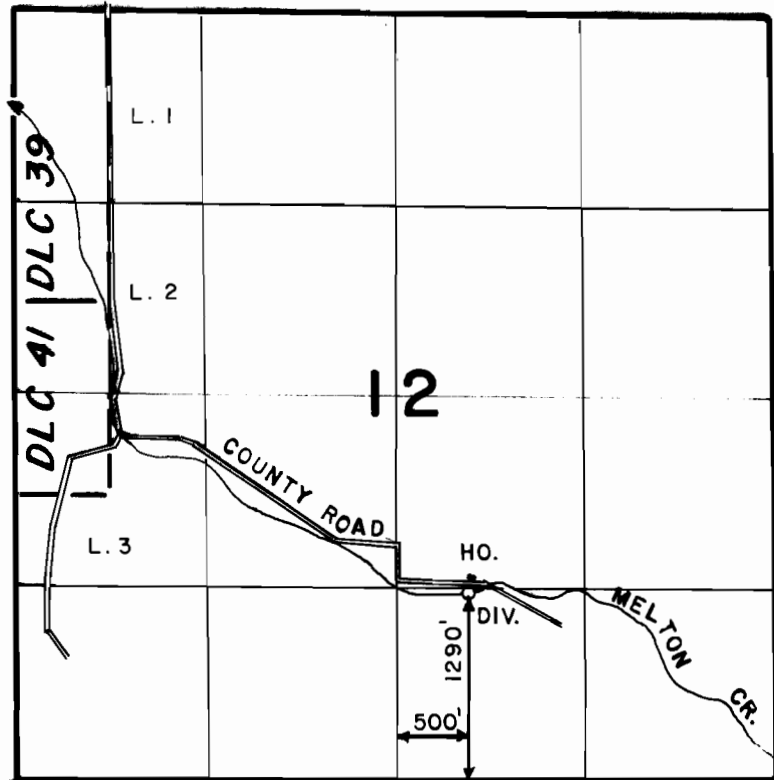

SCALE: 4" = 1 MILE

FINAL PROOF SURVEY
UNDER

Application No. 68545... Permit No. 49585.....
IN NAME OF

HARLAN F. MELTON

Surveyed JAN. 8..... 1988, by J.M. SCHMORDE.