

STATE ENGINEER
RECEIVED

JUN 9 1925


SALEM, OREGON

2/21/9

Antelope Creek

T 22

R 24

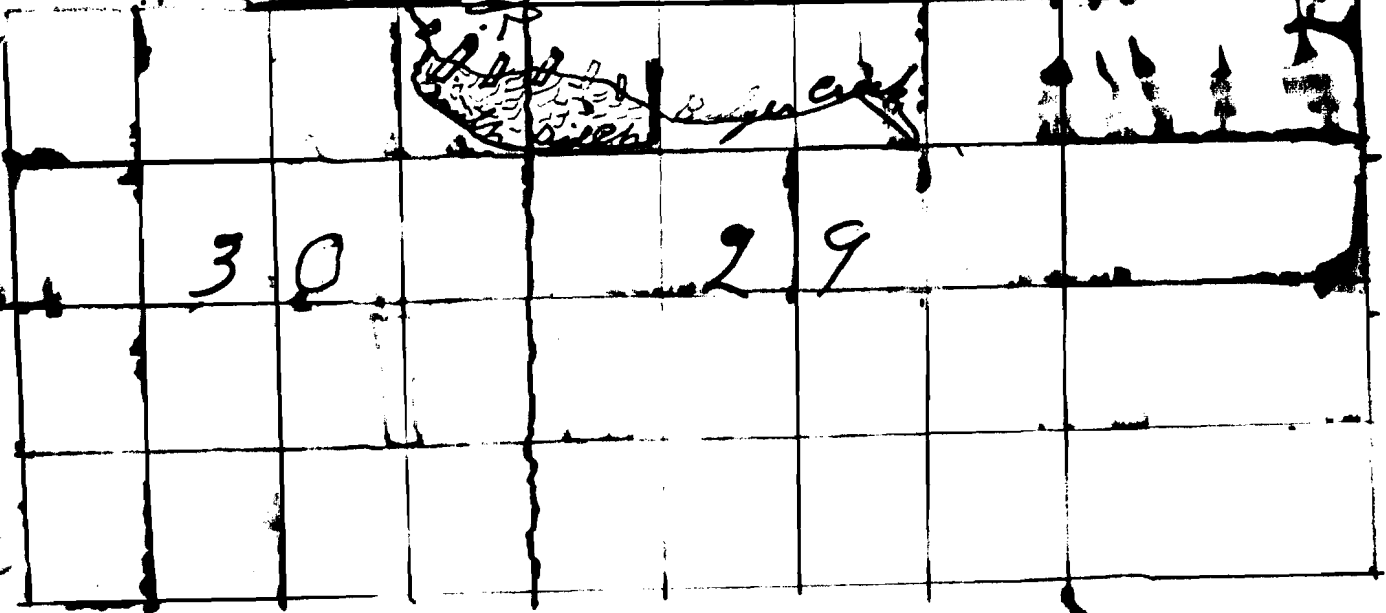

Surveyed and Plotted by Paul P. Wenzel

Application No 9012
Permit No 5918